

MISSISSIPPI DEPARTMENT OF NATURAL RESOURCES

Bureau of Land and Water Resources

Southport Mall

P.O. Box 10631

Jackson, Mississippi 39209

WATER WELL DRILLERS LOG

Jackson
02174

8-10-82, Coast Water Well Sew. Jackson
date well completed firm name county well located

LANDOWNER: Roger McCoy

description of formations encountered

from

to

P.O. Box 2414
Muscogee, Ala.
(mailing address) 35403

Top soil 0 10'

Blue Clay 10' 38'

Gray Coarse sand 38' 70'

Blue Clay & Chert Shell 70' 258'

Blue Clay 258' 310'

Blue Clay & Shell sand 310' 365'

Blue Clay & Chert Shell 365' 500'

Gray fine sand 500' 514'

Gray Coarse sand 514' 570'

WELL LOCATION:

sec 5 T 8 R 7
3 1/2 miles SW of GALTIER
(distance) (direction) (nearest town)

WELL PURPOSE: Home
(home, irrigation, municipal, industrial)

WELL COMPLETION DATA:

(1) diameter (inches) 2"
(2) total depth (feet) 570'
(3) static water level (feet) 36 (below top of ground)

(4) casing PVC, 550'
(material) (depth)
3" (size) if telescope see back.

(5) screen 20', 550'
(length) (depth to top)
2" PVC
(size) (material)

(6) pump 1 hp, 9 gpm
(HP) (yield gpm)
Elec
(type power)

(7) electric log No.
(yes or no)
(organization running log)

(8) how well bottom plugged
Backwash Valve

DRILLERS REMARKS:


DEPT. OF NATURAL RESOURCES
BUREAU OF LAND & WATER RESOURCES

SEP 30 1982

RECEIVED

If well telescopes please sketch and show depths.

GROUND LEVEL

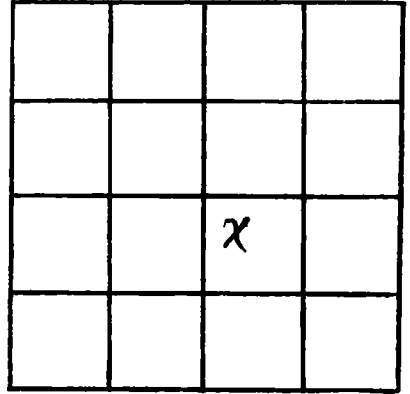

SECTION 5

Please indicate well location X.

ADDITIONAL INFORMATION

A series of horizontal lines for writing additional information, starting below the 'ADDITIONAL INFORMATION' header and extending to the bottom of the page.

If more than one screen, show locations of each on sketch.