

MISSISSIPPI DEPARTMENT OF NATURAL RESOURCES

Bureau of Land and Water Resources

Southport Mall

P.O. Box 10631

Jackson, Mississippi 39209

WATER WELL DRILLERS LOG

Jackson
02176

8-20-1982

82 Coast & Water Well Sew.

Jackson

date well completed

firm name

county well located

LANDOWNER:

Logan Cotton

506 Williams St.

P.O. Box 308, Hattiesburg, Ms.
(mailing address)

description of formations encountered

from

to

Top soil	0	2'
Red Clay	2'	18'
White Coast sand	18'	22'
Blue Clay	22'	65'
Gray Coarse sand & wood	65'	86'
Gray Coarse sand and gravel	86'	126'
Blue Clay & Strata of sand	126'	130'
Gray Coarse sand & gravel	130'	150'
Blue Clay	150'	195'
Gray Coarse sand	195'	279'

WELL LOCATION:

sec. 36 T-7 N R-76 W
1/4 miles (distance) of GAULTIER (direction) of (nearest town)

WELL PURPOSE:

(home, irrigation, municipal, industrial)

None

WELL COMPLETION DATA:

- (1) diameter (inches) 4"
- (2) total depth (feet) 279'
- (3) static water level (feet) 20' below top of ground
- (4) casing PVC (material), 269' (depth)
4" (size) if telescope see back.
- (5) screen 10' (length), 269' (depth to top)
4" (size), PVC (material)
- (6) pump 1/2 HP (HP), 25 (yield gpm)
Elect (type power)
- (7) electric log No (yes or no)
- (organization running log)

(8) how well bottom plugged
Back Wash Valve


DRILLERS REMARKS:

DEPT. OF NATURAL RESOURCES
BUREAU OF LAND & WATER RESOURCES

SEP 30 1982
RECEIVED

If well telescopes please sketch and show depths.

GROUND LEVEL

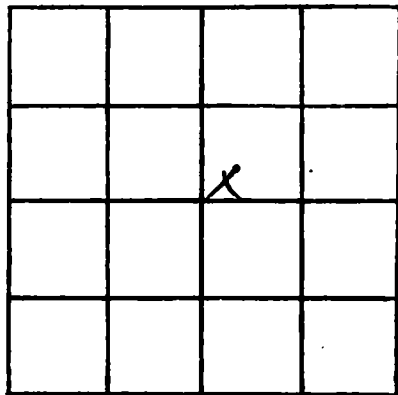

SECTION 36

Please indicate well location X.

ADDITIONAL INFORMATION

A series of horizontal lines for writing additional information, starting below the 'ADDITIONAL INFORMATION' header and extending to the bottom of the page.

If more than one screen, show locations of each on sketch.