

MISSISSIPPI DEPARTMENT OF NATURAL RESOURCES

Bureau of Land and Water Resources

Southport Mall

P.O. Box 10631

Jackson, Mississippi 39209

WATER WELL DRILLERS LOG

COASTAL DRILLING & SERVICE CO.

ROUTE 1 BOX 618

BILOXI, MISS. 39532

Jackson
02177

10/5/82
date well completed

Jackson
county well located

LANDOWNER: Donald Chandler

description of formations encountered

from to

Vencluse Cutoff Rd
Marion, Ms
(mailing address)

top soil	1	3
Red Clay	3	15
white Clay	15	40
Sandy Sand	40	65
Silt Bling Clay	65	375
fine water sand	375	400
fine water sand	400	430
		hole

WELL LOCATION:

sec 3 T 7 N R 2 E
2 1/2 miles (distance) S (direction) of I-10 (nearest town)

WELL PURPOSE: home
(home, irrigation, municipal, industrial)

WELL COMPLETION DATA:

- (1) diameter (inches) 2"
- (2) total depth (feet) 430'
- (3) static water level (feet) 42' below above top of ground
- (4) casing PVC (material), 420' (depth)
- (size) if telescope see back.
- (5) screen 10' (length), 420' (depth to top)
- 2" (size), PVC (material)
- (6) pump 1/2 (HP), 13 (yield gpm)
- Electric (type power)
- (7) electric log no (yes or no)

(organization running log)

(8) how well bottom plugged 2" steel well tubes

DRILLERS REMARKS: 198


DEPT. OF NATURAL RESOURCES
BUREAU OF LAND & WATER RESOURCES

NOV 30 1982

RECEIVED

If well telescopes please sketch and show depths.

GROUND LEVEL

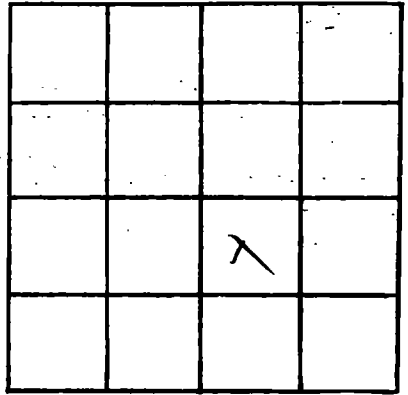

SECTION _____

Please indicate well location X.

ADDITIONAL INFORMATION

If more than one screen,
show locations of each on sketch.