

MISSISSIPPI DEPARTMENT OF NATURAL RESOURCES

Bureau of Land and Water Resources

Southport Mall

P.O. Box 10631

Jackson, Mississippi 39209

WATER WELL DRILLERS LOG

11-15-82

date well completed

Coast Water Well Service Jackson

firm name

county well located

LANDOWNER:

Paul J. Sessum

description of formations encountered

from

to

2408 West Gate Hwy
Gautier, Miss.
(mailing address) 39153

Top soil	0	5'
Purple Clay	5'	10'
Red Clay	10'	43'
Blue Clay	43'	130'
Gray Coarse sand	130'	185'
Gray Coarse sand & gravel	185'	190'
Blue Clay	190'	230'
Gray Coarse sand	230'	256'
Blue Clay	256'	350'
Gray Coarse sand	350'	400'

WELL LOCATION:

sec 5 T 7 N R 7 E
5 miles S of VAN CLEAVE
(distance) (direction) (nearest town)

WELL PURPOSE:

(home, irrigation, municipal, industrial)

Home

WELL COMPLETION DATA:

- (1) diameter (inches) 2"
- (2) total depth (feet) 400'
- (3) static water level (feet) 63' (below ground top of ground)
- (4) casing PVC 390' (material) (depth)
5" (size) if telescope see back.
- (5) screen 10' 390' (length) (depth to top)
2" PVC (size) (material)
- (6) pump 1/2 HP (type power) 7 (yield gpm)
- (7) electric log No. (yes or no)

DEPT. OF NATURAL RESOURCES
BUREAU OF LAND & WATER RESOURCES

DEC 31 1982


RECEIVED

DRILLERS REMARKS:

(8) How well bottom plugged
Back wash valve

If well telescopes please sketch and show depths.

GROUND LEVEL

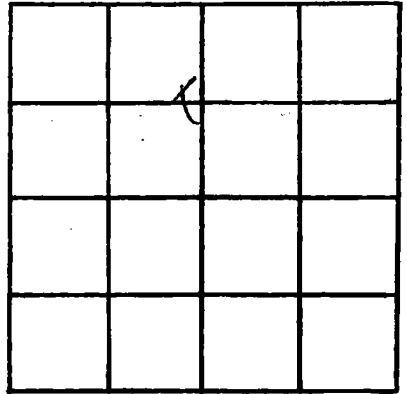

SECTION 5

Please indicate well location X.

ADDITIONAL INFORMATION

If more than one screen,
show locations of each on sketch.