

MISSISSIPPI DEPARTMENT OF NATURAL RESOURCES

Bureau of Land and Water Resources

Southport Mall

P.O. Box 10631

Jackson, Mississippi 39209

WATER WELL DRILLERS LOG

Jackson  
0 2182

2-3-1983 date well completed  
23 Cross Water Well Serv. firm name  
Jackson county well located

LANDOWNER: Thomas Hagan  
707 Mill Rd.  
Pascagoula Miss.  
(mailing address) 39267

description of formations encountered	from	to
Sandy Topsoil	0	5'
B. Clay	5'	38'
Co. Sand B.	38'	83'
B. Clay	83'	125'
M. Sand	125'	156'
B. Clay	156'	225'
M. Sand	225'	270'

WELL LOCATION:  
sec. 31 T. 7 S. R. 7 E.  
1N miles of GAUQUIER  
(distance) (direction) (nearest town)

WELL PURPOSE: None  
(home, irrigation, municipal, industrial)

WELL COMPLETION DATA:

(1) diameter (inches) 2"

(2) total depth (feet) 270'

(3) static water level (feet) 35' (below top of ground)

(4) casing PVC, 260' CL  
(material) (depth)  
2" If telescope see back.  
(size)

(5) screen 10', 260'  
(length) (depth to top)  
2" PVC  
(size) (material)

(6) pump 1/2, 5  
(HP) (yield gpm)  
Check.  
(type power)

(7) electric log No  
(yes or no)

(organization running log)

(8) how well bottom plugged  
Crack Wash Valve

DRILLERS REMARKS:


DEPT. OF NATURAL RESOURCES  
BUREAU OF LAND & WATER RESOURCES

APR 27 1983

RECEIVED

If well telescopes please sketch and show depths.

GROUND LEVEL

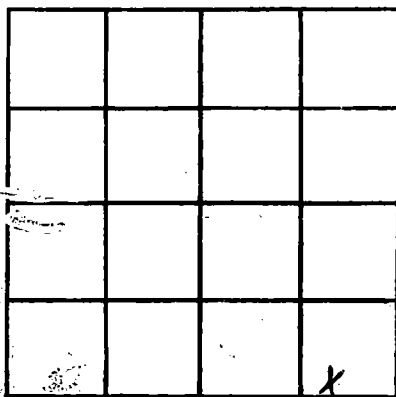

SECTION 31

Please indicate well location X.

ADDITIONAL INFORMATION

If more than one screen, show locations of each on sketch.