

MISSISSIPPI DEPARTMENT OF NATURAL RESOURCES

Bureau of Land and Water Resources

Southport Mall

P.O. Box 10631

Jackson, Mississippi 39209

WATER WELL DRILLERS LOG

Jackson
0284

5-13-83
date well completed

Coast Water Well Sew.

firm name

Jackson
county well located

LANDOWNER:

Henry O. Ridgwell

description of formations encountered

from

to

3000 Ridgwell Rd.

Top soil

0 5'

Planters, Miss.
(mailing address) 39153

Red Clay

5' 10'

WELL LOCATION:

sec. 11 T 7 N R 7 E
4 miles NE of Ocean Springs
(distance) (direction) (nearest town)

Blue Clay

10' 40'

White Coarse sand

40' 43'

WELL PURPOSE:

(home, irrigation, municipal, industrial)

Home

White Coarse sand

43' 65'

& wood

WELL COMPLETION DATA:

- (1) diameter (inches) 4" x 2"
- (2) total depth (feet)
- (3) static water level (feet) 60' (below top of ground)
- (4) casing PVC, 4.33' (material) (depth)
4" x 2" (size) If telescope see back.
- (5) screen 20' (length), 4.33' (depth to top)
4" x 2" (size), PVC (material)
- (6) pump (HP) (yield gpm)
ELECT. (type power)
- (7) electric log No. (yes or no)
(organization running log)

Blue Clay

65' 85'

White Coarse sand

85' 110'

Blue Clay & shell

110' 150'

of sand

150' 190'

Blue Clay

190' 215'

Gray Coarse sand

215' 401'

Blue Clay

401' 453'

Gray Coarse sand

453' Hole

DEPT. OF NATURAL RESOURCES
BUREAU OF LAND & WATER RESOURCES



JUN 23 1983

RECEIVED

(8) How well bottom plugged
Back Water Valve

DRILLERS REMARKS:

If well telescopes please sketch and show depths.

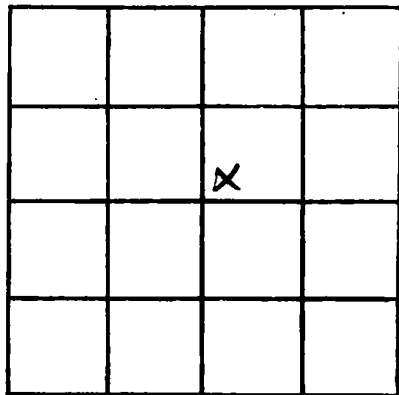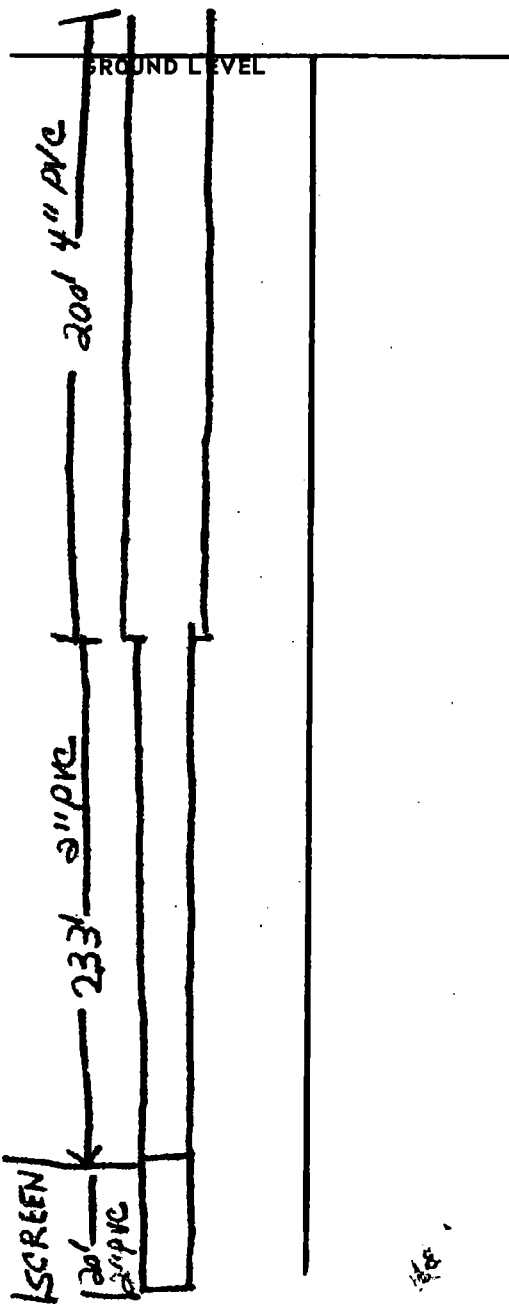

SECTION 17

Please indicate well location X.

ADDITIONAL INFORMATION

If more than one screen, show locations of each on sketch.