

Jackson  
JUL 27 1983  
02186

RECEIVED  
9-23-19

Water Well Sew. Jackson

date well completed... firm name... county well located

LANDOWNER: Wallace Caskey  
1221 Birchwell Blvd  
Ocean Springs, Miss 39564  
(mailing address)

WELL LOCATION:  
sec. 19 T. 8 N. R. 7 E  
4 miles SW of GAULTIER  
(distance) (direction) (nearest town)

WELL PURPOSE: Home  
(home, irrigation, municipal, industrial)

WELL COMPLETION DATA:

- (1) diameter (inches) 2"
- (2) total depth (feet) 484'
- (3) static water level (feet) 49' <sup>below</sup> top of ground.
- (4) casing PVC 464' (material) (depth)  
2" (size) if telescope see back.
- (5) screen 20' 464' (length) (depth to top)  
2" (size) PVC (material)
- (6) pump 2hp 12 (HP) (yield gpm)  
check (type power)
- (7) electric log No. (yes or no)

(organization running log)


(8) how well bottom plugged  
backwash valve

description of formations encountered	from	to
<u>Top soil</u>	<u>0</u>	<u>1'</u>
<u>Brown coarse sand</u>	<u>1'30"</u>	
<u>White coarse sand &amp; gravel</u>	<u>30'</u>	<u>100'</u>
<u>Blue clay</u>	<u>100'</u>	<u>183'</u>
<u>Gray med. sand</u>	<u>183'</u>	<u>226'</u>
<u>Blue clay &amp; streak of sand</u>	<u>226'</u>	<u>306'</u>
<u>Gray coarse sand</u>	<u>306'</u>	<u>322'</u>
<u>Gray fine sand</u>	<u>322'</u>	<u>327'</u>
<u>Blue clay &amp; streak of sand</u>	<u>327'</u>	<u>461'</u>
<u>Gray coarse sand</u>	<u>461'</u>	<u>484'</u>

DRILLERS REMARKS:

If well telescopes please sketch and show depths.

GROUND LEVEL

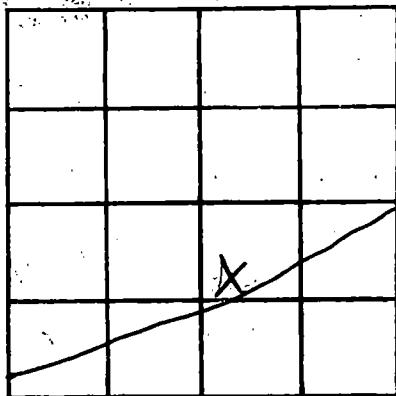

SECTION 19

Please indicate well location X.

ADDITIONAL INFORMATION

If more than one screen,  
show locations of each on sketch.