

MISSISSIPPI DEPARTMENT OF NATURAL RESOURCES

Bureau of Land and Water Resources

Southport Mall

P.O. Box 10631

Jackson, Mississippi 39209

WATER WELL DRILLERS LOG

Jackson
02188

7-18-83

date well completed

19 Back Waters Well Sew. Jackson

firm name

county well located

LANDOWNER:

Alan Quinn

description of formations encountered

from

to

2602 Ice Mountain Rd.

Top soil

0 2'

Ocean Springs, Ms.

Red coarse sandstone

2 40'

(mailing address) 37524

WELL LOCATION:

Blue Clay Shale Sand

40' 65'

sec. 8 T. 8 N. R. 7 W.

Blue Clay

65' 180'

4 miles SE of OCEAN SPRINGS

Gray Med sand

180' 300'

WELL PURPOSE: Home
(home, irrigation, municipal, industrial)

Blue Clay

300' 280'

WELL COMPLETION DATA:

Blue Clay Shale Sand

280' 325'

(1) diameter (inches) 2"

Blue Clay

325' 445'

(2) total depth (feet) 491'

(3) static water level (feet) 61' below top of ground.

Gray Coarse sand

445' 480'

(4) casing PVC 481'
(material) (depth)

Blue Clay

480' 491'

2" If telescope see back.
(size)

(5) screen 10' 481'
(length) (depth to top)

2" PVC
(size) (material)

(6) pump 1/2 HP 7
(HP) (yield gpm)

Elect.
(type power)

(7) electric log No
(yes or no)

(organization running log)

(8) how well bottom plugged Back Wash Valve

DRILLERS REMARKS:


DEPT. OF NATURAL RESOURCES
BUREAU OF LAND & WATER RESOURCES

SEP 21 1983

RECEIVED

If well telescopes please sketch and show depths.

GROUND LEVEL

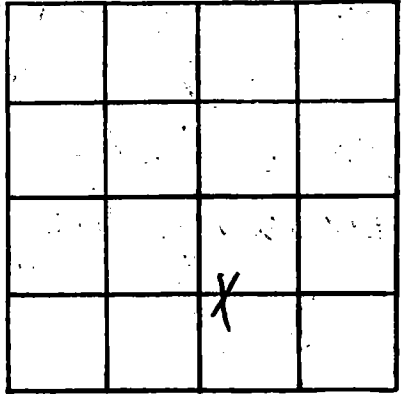

SECTION 1

Please indicate well location X.

ADDITIONAL INFORMATION

If more than one screen, show locations of each on sketch.