

MISSISSIPPI DEPARTMENT OF NATURAL RESOURCES

Bureau of Land and Water Resources

Southport Mall

P.O. Box 10631

Jackson, Mississippi 39209

WATER WELL DRILLERS LOG

Jackson, Miss.
9/21/83
J.M. [unclear]

7-11-83

Coast Water Well Sew. Jackson

date well completed

firm name

county well located

LANDOWNER

Stem Mattie
5708 Hwy 90
Gautier, Ms.
(mailing address) 39253

description of formations encountered

from to

WELL LOCATION:

sec. 5 T. 7 S. R. 7
5 1/2 miles of VAN CLEAVE
(distance) (direction) (nearest town)

Top soil	0	2'
Red Clay	2	5'
Red Coarse sand	5	39'
Blue Clay	39'	63'
White Coarse sand	63'	80'

WELL PURPOSE:

Home (home, irrigation, municipal, industrial)

WELL COMPLETION DATA:

- (1) diameter (inches) 2"
- (2) total depth (feet) 80'
- (3) static water level (feet) 39' below top of ground
- (4) casing PVC, 70', CL (material) (depth)
- 2" (size) If telescope see back.
- (5) screen 10', 70' (length) (depth to top)
- 2" PVC (size) (material)
- (6) pump (HP) (yield gpm)
- Elect. (type power)
- (7) electric log No. (yes or no)

(organization running log)

(8) How well bottom plugged back wash valve

DRILLERS REMARKS:


DEPT. OF NATURAL RESOURCES BUREAU OF LAND & WATER RESOURCES

SEP 21 1983

RECEIVED

If well telescopes please sketch and show depths.

GROUND LEVEL

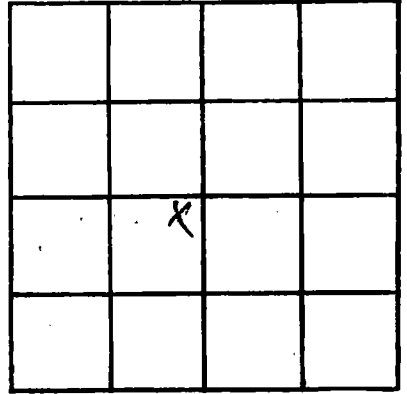

SECTION 5

Please indicate well location X.

ADDITIONAL INFORMATION

If more than one screen, show locations of each on sketch.