

MISSISSIPPI DEPARTMENT OF NATURAL RESOURCES

Bureau of Land and Water Resources

Southport Mall

P.O. Box 10631

Jackson, Mississippi 39209

WATER WELL DRILLERS LOG
COASTAL DRILLING & SERVICE CO.Jackson
021918/25/83 19
date well completed

ROUTE 1 BOX 618

Jackson
county well located

LANDOWNER:

T.B. Belle

Hippard Etts

Rt 3 Box 618 N Ocean Spring
(mailing address)

WELL LOCATION:

sec. T 8 N R 2 W
Hippard Etts
(distance) (direction) (nearest town)

WELL PURPOSE:

(home, irrigation, municipal, industrial)

WELL COMPLETION DATA:

- (1) diameter (inches) 2"
 (2) total depth (feet) 450'
 (3) static water level (feet) 450 below top of ground.
 (4) casing PVC, 440',
 (material) (depth)

 if telescope see back.
(size)

- (5) screen 10', 840'
 (length) (depth to top)
2", PVC
 (size) (material)

- (6) pump 1/2 HP, 10
 (HP) (yield gpm)

Elle
(type power)

- (7) electric log 700
 (yes or no)

(organization running log)

- (8) how well bottom plugged
2' off bottom

DRILLERS REMARKS: 19-8

description of formations encountered	from	to
Top Soil	13	
White Sand	3	15
Coarse White Sand	15	25
Sandy Sand	25	90
Soft Blue Clay	90	240
Fine White Sand	140	265
Hard Blue Clay	265	400
Fine White Sand	400	420
Soft White Sand	420	450
		Hole



DEPT. OF NATURAL RESOURCES
DIVISION OF LAND AND WATER RESOURCES

JUN 29 1984

RECEIVED

If well telescopes please
sketch and show depths.

GROUND LEVEL

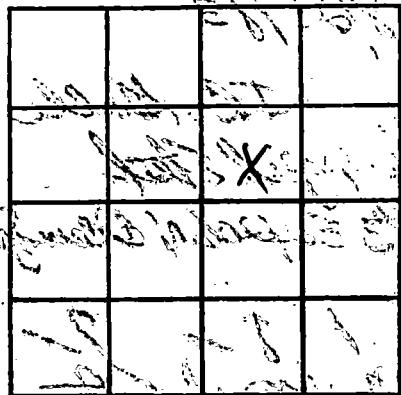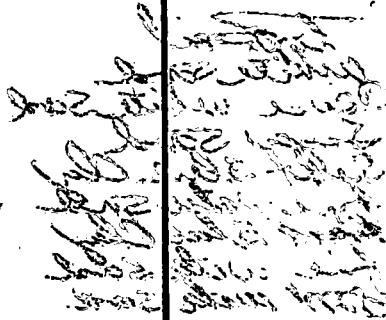

SECTION

Please indicate well location X.

ADDITIONAL INFORMATION

If more than one screen,
show locations of each on sketch.