

MISSISSIPPI DEPARTMENT OF NATURAL RESOURCES

Bureau of Land and Water Resources

Southport Mall

P.O. Box 10631

Jackson, Mississippi 39209

WATER WELL DRILLERS LOG

Jackson  
0 7194

10-12-83 date well completed  
Coast Water Well Serv. firm name  
Jackson county well located

LANDOWNER	description of formations encountered	from	to
D. L. Gregory Rt 6 - Box 146	Top soil	0	5'
Ocean Springs Mini (mailing address) 35564	Red Clay	5'	31'
WELL LOCATION: sec. 8 T. 7 R. 2 3 miles NE of Ocean Springs (distance) (direction) (nearest town)	Blue Clay	31'	40'
WELL PURPOSE: Home (home, irrigation, municipal, industrial)	Red Coarse sand	40'	100'
WELL COMPLETION DATA: (1) diameter (inches) 2" (2) total depth (feet) 221' (3) static water level (feet) 27' below top of ground. (4) casing PVC, 211' u (material) (depth) 2" (size) If telescope see back. (5) screen 10' 211' (length) (depth to top) 2" PVC (size) (material), (6) pump 1 hp. 10' (type power) (yield gpm) Elec. (type power) (7) electric log No (yes or no) (organization running log) (8) how well bottom plugged backwash valve	Blue Clay	100'	150'
	Blue Clay & thick of sand	150'	170'
	Gray Coarse sand	170'	221'
			48e

MISS. DEPT. OF NATURAL RESOURCES  
BUREAU OF LAND & WATER RESOURCES


DEC 19 1983

RECEIVED

DRILLERS REMARKS:

If well telescopes please sketch and show depths.

GROUND LEVEL

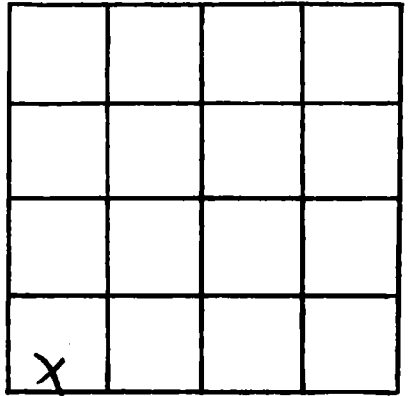

SECTION 8

Please indicate well location X.

ADDITIONAL INFORMATION

If more than one screen, show locations of each on sketch.