

MISSISSIPPI DEPARTMENT OF NATURAL RESOURCES
Bureau of Land and Water Resources
 Southport Mall
 P.O. Box 10631
 Jackson, Mississippi 39209
WATER WELL DRILLERS LOG

Jackson
02196

10-27-83 19 Coast Water Well Sew. Jackson
 date well completed firm name county well located

Jackson County Register
 LANDOWNER:
P.O. Box 1726
Pascagoula, Miss.
 (mailing address) 395-67

WELL LOCATION:
 sec 27 7A R 7
1/2 miles W of CAUTION
 (distance) (direction) (nearest town)

WELL PURPOSE:
 (home, irrigation, municipal, industrial)

WELL COMPLETION DATA:

(1) diameter (inches) 2"

(2) total depth (feet) 419'

(3) static water level (feet) 42' ^{below} ~~above~~ top of ground.

(4) casing PVC, 409' CL
 (material) (depth)
2" If telescope see back.
 (size)

(5) screen 10', 409'
 (length) (depth to top)
2" PVC
 (size) (material)

(6) pump -10-
 (HP) (yield gpm)
Elect.
 (type power)

(7) electric log No.
 (yes or no)

 (organization running log)

description of formations encountered	from	to
Top soil	0	3'
Blue Clay	3'	30'
White Coarse sand & gravel	30'	69'
Blue Clay	69'	118'
White Coarse sand	118'	145'
White Coarse sand & wood	145'	155'
Blue Clay	155'	170'
Gray Coarse sand	170'	236'
Gray Coarse sand & wood	236'	290'
Blue Clay	290'	366'
Gray Coarse sand	366'	384'
Blue Clay	384'	388'
Gray Coarse sand	388'	411'
Gray Coarse sand & wood	411'	419'

DEPT. OF NATURAL RESOURCES
 BUREAU OF LAND & WATER RESOURCES

DEC 10 1983


RECEIVED

(8) How well bottom plugged:
Cashed valve

DRILLERS REMARKS:

If well telescopes please sketch and show depths.

GROUND LEVEL

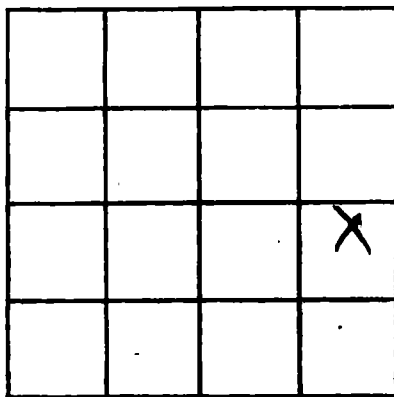

SECTION 27

Please indicate well location X.

ADDITIONAL INFORMATION

If more than one screen, show locations of each on sketch.