

MISSISSIPPI DEPARTMENT OF NATURAL RESOURCES

Bureau of Land and Water Resources

Southport Mall

P.O. Box 10631

Jackson, Mississippi 39209

WATER WELL DRILLERS LOG

Jackson
02197

10-24-83
date well completed

Coast Water Well Sew.
firm name

Jackson
county well located

LANDOWNER: J.M. Erwin

description of formations encountered

from to

3712 Townsend Dr.

Top soil

0 2'

Sautier Miss.
(mailing address) 39533

Red Clay

2' 13'

WELL LOCATION:

Blue Clay

12' 18'

sec. 36 T-7 S R-2
1 N miles of SAUTIER
(distance) (direction) (nearest town)

White Coarse sand

18' 22'

WELL PURPOSE: Home
(home, irrigation, municipal, industrial)

Blue Clay

22' 50'

WELL COMPLETION DATA:

Gray Coarse sand & Wood

50' 75'

(1) diameter (inches) 4"

Blue Clay & Wood

75' 97'

(2) total depth (feet) 253'

(3) static water level (feet) 22' below top of ground.

Gray Coarse sand & gravel

97' 140'

(4) casing PVC, 243' CL
(material) (depth)

Blue Clay

140' 172'

4" if telescope see back.
(size)

Blue Clay, streak of sand

172' 188'

(5) screen 10' length, 243' depth to top

Gray Coarse sand

188' 253'
452'

4" PVC
(size) (material)

(6) pump 1 hp, 30' (HP) (yield gpm)

Elect.
(type power)

(7) electric log No.
(yes or no)

(organization running log)

(8) how well bottom plugged: Back Wash Valve

DRILLERS REMARKS:


DEPT. OF NATURAL RESOURCES
BUREAU OF LAND & WATER RESOURCES

DEC 10 1983

RECEIVED

If well telescopes please sketch and show depths.

GROUND LEVEL

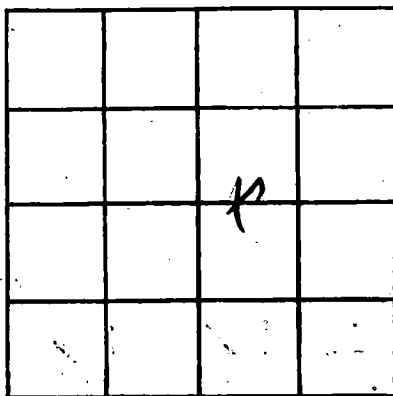

SECTION 36

Please indicate well location X.

ADDITIONAL INFORMATION

If more than one screen, show locations of each on sketch.