

MISSISSIPPI DEPARTMENT OF NATURAL RESOURCES

Bureau of Land and Water Resources

Southport Mall

P.O. Box 10631

Jackson, Mississippi 39209

WATER WELL DRILLERS LOG

Jackson  
D 2198

2-4-84

Coast Water Well Serv. Jackson

date well completed

firm name

county well located

LANDOWNER:

Clair Hester

description of formations encountered

from

to

P.O. Box 1771  
Pascagoula Miss.  
(mailing address)

Top soil

0 2'

WELL LOCATION:  
sec. 26 T 7 N R 7 W S  
IN miles of GAUJER  
(distance) (direction) (nearest town)

Red Clay

2' 7'

WELL PURPOSE: Home  
(home, irrigation, municipal, industrial)

Blue Clay

7' 4.5'

WELL COMPLETION DATA:

Blue Clay & Wood

4.5' 80'

(1) diameter (inches) 2"

White Coarse sand & wood

80' 112'

(2) total depth (feet) 279'

Blue Clay

112' 190'

(3) static water level (feet) 27' below top of ground.

Gray Coarse sand

190' 270'

(4) casing PVC 269' (material) (depth)

Gray Coarse sand & gravel

270' 276'

(5) screen 10' 269' (length) (depth to top)

Blue Clay

276' 279'

(6) pump 2" PVC (size) (material)

10'-2" Tail Pipe

(7) electric log No. (type power) (yes or no)

DEPT. OF NATURAL RESOURCES  
BUREAU OF LAND & WATER RESOURCES

(8) how well bottom plugged back wash valve


APR 30 1984

RECEIVED

DRILLERS REMARKS:

If well telescopes please sketch and show depths.

GROUND LEVEL

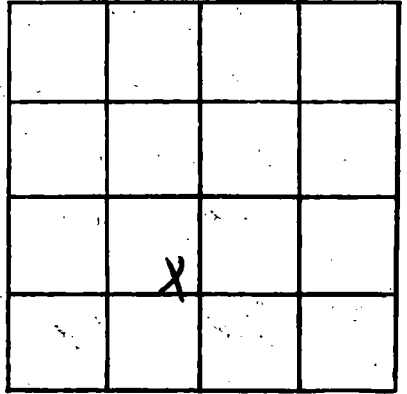

SECTION 26

Please indicate well location X.

ADDITIONAL INFORMATION

If more than one screen, show locations of  on sketch.

