

MISSISSIPPI DEPARTMENT OF NATURAL RESOURCES

Bureau of Land and Water Resources

Southport Mall

P.O. Box 10631

Jackson, Mississippi 39209

WATER WELL DRILLERS LOG

JACKSON
Q 2902

4-13-80 84 Cross Water Well Serv. Jackson
date well completed firm name county well located

LANDOWNER: Benjamin Beard
8317 Hwy 57
Ocean Springs, Miss.
(mailing address) 39564

WELL LOCATION:
sec. 6 T. 7N R. 7E
5 miles NE of OCEAN SPRINGS
(distance) (direction) (nearest town)

WELL PURPOSE: None
(home, irrigation, municipal, industrial)

WELL COMPLETION DATA:
(1) diameter (inches) 2"
(2) total depth (feet) 370'
(3) static water level (feet) 52' below top of ground.
(4) casing PVC, 360' (material) (depth)
2" (size) if telescope see back.
(5) screen 10' (length), 360' (depth to top)
2" (size) PVC (material)
(6) pump 1 HP, 8 1/2 (yield gpm)
Elec. (type power)
(7) electric log No. (yes or no)
(organization running log)
(8) how well bottom plugged
Back Wash Valve

description of formations encountered	from	to
Top soil	0	3'
Red Clay	3'	5'
Gray Clay	5'	15'
Red Coarse sand	15'	76'
Red Clay	76'	106'
Blue Clay	106'	150'
Gray Coarse sand	150'	177'
Blue Clay	177'	338'
6" Rock	338'	
Blue Clay	338'	354'
Gray Coarse sand	354'	370'
No Tail Pipe		

DEPT. OF NATURAL RESOURCES
BUREAU OF LAND & WATER RESOURCES


JUL 10 1984

RECEIVED

DRILLERS REMARKS:

If well telescopes please sketch and show depths.

GROUND LEVEL

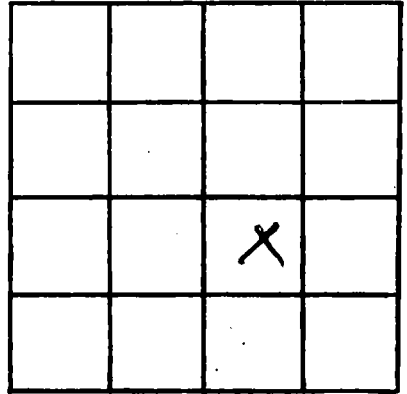

SECTION 6

Please indicate well location X.

ADDITIONAL INFORMATION

If more than one screen, show locations of each on sketch.