

MISSISSIPPI DEPARTMENT OF NATURAL RESOURCES

Bureau of Land and Water Resources

Southport Mall

P.O. Box 10631

Jackson, Mississippi 39209

WATER WELL DRILLERS LOG

JACKSON
 2903

5-1-1984 date well completed
 84 Coast Water Well Sew. firm name
 Jackson county well located

Howard Constructors
 LANDOWNER

2303 Paisley Ave.
 Pascagoula Miss.
 (mailing address) 39567

WELL LOCATION:
 sec. 36 T 7 N R 7 E
 IN miles of GAUTIER
 (distance) (direction) (nearest town)

WELL PURPOSE: None
 (home, irrigation, municipal, industrial)

WELL COMPLETION DATA:
 (1) diameter (inches) 2"
 (2) total depth (feet) 301'
 (3) static water level (feet) 26' below top of ground.
 (4) casing PVC 291' CL (material) (depth)
 2" (size) If telescope see back.
 (5) screen 10' 291' (length) (depth to top)
 2" PVC (material) (size)
 (6) pump 1 HP 10 (type power) (yield gpm)
 (7) electric log No. (yes or no)
 (organization running log)

description of formations encountered	from	to
Top soil	0	3'
Red Clay	3'	10'
Blue Clay	10'	31'
Blue Clay & Capstan Shell	31'	40'
Blue Clay	40'	60'
Gray Coarse sand and Wood	60'	112'
Blue Clay	112'	130'
Gray Coarse sand	130'	218'
Blue Clay	218'	235'
Gray fine sand	235'	238'
Gray med sand & wood	238'	270'
Gray Coarse sand	270'	291'
Gray Coarse sand Gravel & Wood	291'	298'
Blue Clay	298'	301'


(8) how well bottom plugged
 Back Wash Valve

DRILLERS REMARKS:

10'-2" Tail Pipe
 DEPT. OF NATURAL RESOURCES
 BUREAU OF LAND AND WATER RESOURCES
 JUL 10 1984
RECEIVED

If well telescopes please sketch and show depths.

GROUND LEVEL

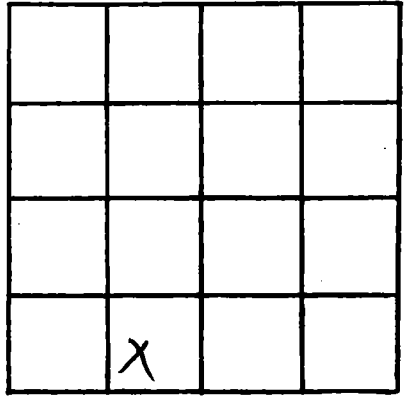

SECTION 36

Please indicate well location X.

ADDITIONAL INFORMATION

A series of horizontal lines for writing additional information.

If more than one screen, show locations of each on sketch.