

MISSISSIPPI DEPARTMENT OF NATURAL RESOURCES

Bureau of Land and Water Resources

Southport Mall

P.O. Box 10631

Jackson, Mississippi 39209

WATER WELL DRILLERS LOG

JACKSON
Q2206

5-10-1984 date well completed
Coast Water Well Sew firm name
Jackson county well located

LANDOWNER: Edward Ward
Phil Davis Rd.
Ocean Springs, Miss.
(mailing address) 37564

WELL LOCATION:
sec. 32 T 7 R 7
3 1/2 miles (distance) W of Ocean Springs (nearest town)

WELL PURPOSE: Home
(home, irrigation, municipal, industrial)

WELL COMPLETION DATA:

(1) diameter (inches) 2"

(2) total depth (feet) 537'

(3) static water level (feet) 65' (below top of ground)

(4) casing PVC, 517' (material), (depth)

2" (size) If telescope see back.

(5) screen 10', 517' (length), (depth to top)

2" PVC (size), (material)

(6) pump (HP), (yield gpm)

(type power)

(7) electric log No (yes or no)

(organization running log)

(8) how well bottom plugged Backwash valve

description of formations encountered	from	to
Top Soil	0'	5'
Red Clay	5'	10'
Blue Clay	10'	51'
Red Coarse Sand & Wood	51'	84'
Blue Clay	84'	100'
Gray Coarse Sand	100'	175'
Blue Clay	175'	475'
Gray Coarse Sand	475'	527'
Blue Clay	527'	537'
10' x 2" PVC Tail Pipe		
517'		
5-8-84		

DEPT. OF NATURAL RESOURCES
BUREAU OF LAND & WATER RESOURCES


JUL 10 1984

RECEIVED

DRILLERS REMARKS:

If well telescopes please sketch and show depths.

GROUND LEVEL

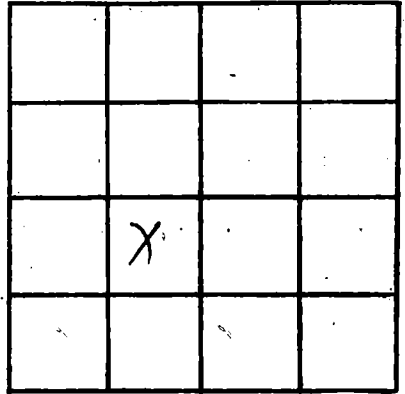

SECTION 32

Please indicate well location X.

ADDITIONAL INFORMATION

If more than one screen,
show locations of each on sketch.