

MISSISSIPPI DEPARTMENT OF NATURAL RESOURCES

Bureau of Land and Water Resources

Southport Mall

P.O. Box 10631

Jackson, Mississippi 39209

WATER WELL DRILLERS LOG

JACKSON
Q 2907

16-1-84 19
date well completed

Cross Water Well Sew. Jackson
firm name county well located

LANDOWNER: Cliff Stumy
Vanclave, Miss
39564
(mailing address)

description of formations encountered	from	to
<u>Clay</u>	<u>0</u>	<u>7'</u>
<u>Sand</u>	<u>7'</u>	<u>95'</u>
		<u>1616</u>

WELL LOCATION:
sec. 6 T. 7 N R. 7 E
5 1/2 miles S of Vanclave
(distance) (direction) (nearest town)

5 1/2" PVC Tail Pipe

WELL PURPOSE:
(home, irrigation, municipal, industrial)

WELL COMPLETION DATA:

(1) diameter (inches) 2"

(2) total depth (feet) 95

(3) static water level (feet) 13' ^{below}/_{above} top of ground.

(4) casing PVC, 85' ct
(material) (depth)

2"
(size) If telescope see back.

(5) screen 10', 85'
(length) (depth to top)

2" PVC
(size) (material)

(6) pump 1/2 hp, 10
(HP) (yield gpm)

Electric
(type power)

(7) electric log No
(yes or no)

(organization running log)

(8) How well bottom plugged
back wash Valve

DRILLERS REMARKS:


DEPT. OF NATURAL RESOURCES
BUREAU OF LAND & WATER RESOURCES

JUL 10 1984

RECEIVED

If well telescopes please sketch and show depths.

GROUND LEVEL

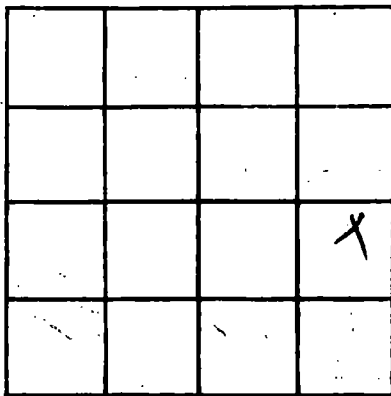

SECTION 6

Please indicate well location X.

ADDITIONAL INFORMATION

If more than one screen, show locations of each on sketch.