

MISSISSIPPI DEPARTMENT OF NATURAL RESOURCES

Bureau of Land and Water Resources

Southport Mall

P.O. Box 10631

Jackson, Mississippi 39209

WATER WELL DRILLERS LOG

JACKSON
Q 2209

6-22-84 19 Coastal Water Well Sew. Jackson.
date well completed firm name county well located

LANDOWNER: Harry O. Ridgwell Jr.
3000 Ridgwell Rd.
Gautier, Miss.
(mailing address) 39333

description of formations encountered	from	to
Red Clay	0	15'
Blue Clay	15'	45'
White sand	45'	73'
Blue Clay	73'	75'
Sand	75'	110'
Blue Clay	110'	175'
White sand	175'	213'
Blue Clay	213'	223'
10" x 2" Tail Pipe		NO LOG

WELL LOCATION:
sec 17 T 7 N R 7 E
4 miles NW of GAUTIER
(distance) (direction) (nearest town)

WELL PURPOSE:
(home, irrigation, municipal, industrial)

WELL COMPLETION DATA:
(1) diameter (inches) 2"
(2) total depth (feet) 223'
(3) static water level (feet) 21' below top of ground
(4) casing PVC, 213' (material) (depth)
2" (size) If telescope see back.
(5) screen 10' (length), 213' (depth to top)
2" (size), PU (material)
(6) pump 1/2 (HP), 8 (yield gpm)
Elec. (type power)
(7) electric log No. (yes or no)
(organization running log)

(8) how well bottom plugged
Pack Work Valve

DRILLERS REMARKS:


DEPT. OF NATURAL RESOURCES
BUREAU OF LAND & WATER RESOURCES

JUL 10 1984

RECEIVED

If well telescopes please sketch and show depths.

GROUND LEVEL

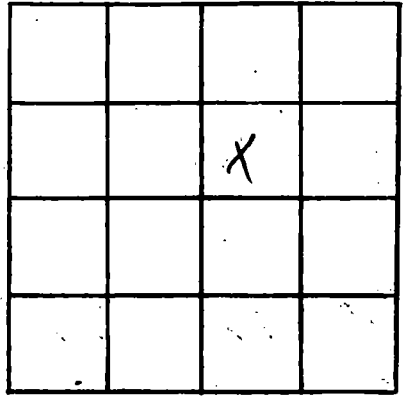

SECTION 17

Please indicate well location X.

ADDITIONAL INFORMATION

If more than one screen, show locations of each on sketch.