

MISSISSIPPI DEPARTMENT OF NATURAL RESOURCES

Bureau of Land and Water Resources

Southport Mall

P.O. Box 10631

Jackson, Mississippi 39209

WATER WELL DRILLERS LOG

JACKSON  
Q2211

6-15-84 19 Coast Water Well Sew. Jackson  
 date well completed firm name county well located

LANDOWNER: Carl Webber  
3525 Suter Rd.  
Gautier, Miss.  
 (mailing address) 39133

WELL LOCATION:  
 sec. 36 T 7 N R 7 W  
1N miles (distance) S (direction) of Gautier (nearest town)

WELL PURPOSE:  
 (home, irrigation, municipal, industrial)

WELL COMPLETION DATA:  
 (1) diameter (inches) 2"  
 (2) total depth (feet) 285'  
 (3) static water level (feet) 23' below top of ground.  
 (4) casing PVC 275'  
 (material) (depth)  
2" If telescope see back.  
 (size)  
 (5) screen 10' 275'  
 (length) (depth to top)  
2" PVC  
 (size) (material)  
 (6) pump \_\_\_\_\_  
 (HP) (yield gpm)  
 (type power) \_\_\_\_\_  
 (7) electric log No  
 (yes or no)  
 (organization running log) \_\_\_\_\_  
 (8) How well bottom plugged:  
back wash valve

description of formations encountered	from	to
<u>Gray Clay</u>	<u>0</u>	<u>15'</u>
<u>Blue Clay</u>	<u>15</u>	<u>65</u>
<u>sand &amp; pea gravel</u>	<u>65</u>	<u>95'</u>
<u>sand &amp; pea gravel</u>	<u>95'</u>	<u>150'</u>
<u>Blue Clay</u>	<u>150'</u>	<u>208'</u>
<u>White sand</u>	<u>208'</u>	<u>285'</u>
<u>5ft - 2" Tail Pipe</u>		<u>None</u>

DEPT. OF NATURAL RESOURCES  
 BUREAU OF LAND & WATER RESOURCES


JUL 10 1984

RECEIVED

DRILLERS REMARKS:

If well telescopes please sketch and show depths.

GROUND LEVEL

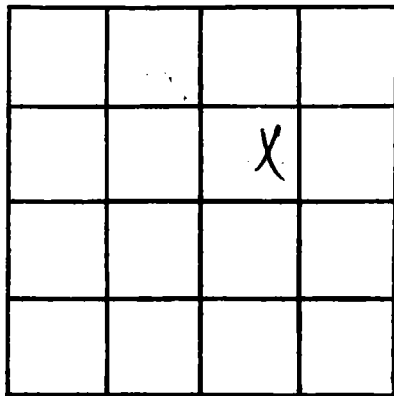

SECTION 36

Please indicate well location X.

ADDITIONAL INFORMATION

If more than one screen, show locations of each on sketch.