

Jackson
 O 2213

MISSISSIPPI DEPARTMENT OF NATURAL RESOURCES
 Bureau of Land and Water Resources
 Southport Mall
 P.O. Box 10631
 Jackson, Mississippi 39209
WATER WELL DRILLERS LOG

7-30 1984 date well completed
 24 Coast Waterwell Sw. firm name
 Jackson county well located

LANDOWNER: C. B. Gibson
Box 6 - Box 64
Ocean Springs, Miss.
 (mailing address) 39164

WELL LOCATION:
 sec. 5 T. 7 R. 7
4 miles 5 of VANCLAVE
 (distance) (direction) (nearest town)

WELL PURPOSE: Home
 (home, irrigation, municipal, industrial)

WELL COMPLETION DATA:
 (1) diameter (inches) 2"
 (2) total depth (feet) 400'
 (3) static water level (feet) 63' ^{below} _{above} top of ground.
 (4) casing PVC, 380' CL
 (material) (depth)
2" if telescope see back.
 (size)
 (5) screen 10' 380'
 (length) (depth to top)
2" PVC
 (size) (material)
 (6) pump 1 8
 (HP) (yield gpm)
elec.
 (type power)
 (7) electric log NO
 (yes or no)
 (organization running log)

description of formations encountered	from	to
<u>Top Soil</u>	<u>0</u>	<u>5</u>
<u>Coarse Sand</u>	<u>5</u>	<u>20</u>
<u>Blue Clay</u>	<u>20</u>	<u>63</u>
<u>Med. Sand</u>	<u>63</u>	<u>94</u>
<u>Blue Clay</u>	<u>94</u>	<u>125</u>
<u>Coarse Sand</u>	<u>125</u>	<u>205</u>
<u>Blue Clay</u>	<u>205</u>	<u>240</u>
<u>Med. Sand</u>	<u>240</u>	<u>263</u>
<u>Blue Clay</u>	<u>263</u>	<u>360</u>
<u>Med Sand</u>	<u>360</u>	<u>395</u>
<u>Blue Clay</u>	<u>395</u>	<u>400</u>
<u>10' x 2" tail pipe</u>		<u>1/2</u>

DEPT. OF NATURAL RESOURCES
 BUREAU OF LAND & WATER RESOURCES

OCT 11 1984


RECEIVED

(8) how well bottom plugged Backward valve

DRILLERS REMARKS:

If well telescopes please sketch and show depths.

GROUND LEVEL

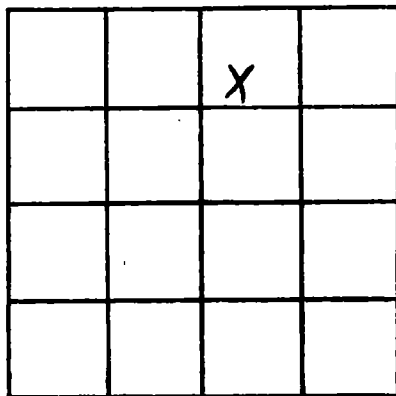

SECTION 5

Please indicate well location X.

ADDITIONAL INFORMATION

If more than one screen,
show locations of each on sketch.