

MISSISSIPPI DEPARTMENT OF NATURAL RESOURCES

Bureau of Land and Water Resources

Southport Mall

P.O. Box 10631

Jackson, Mississippi 39209

WATER WELL DRILLERS LOG

Jackson
2214

10-29-84 19 Coast Water Well Sew. Jackson
 date well completed firm name county well located

LANDOWNER: David W. Hughes
6220 Brown Rd.
Ocean Springs, Miss.
 (mailing address) 39564

description of formations encountered	from	to
	<u>Red Clay</u>	<u>0</u>
<u>Coarse Sand</u>	<u>7</u>	<u>35'</u>
<u>Gray Clay</u>	<u>35'</u>	<u>115'</u>
<u>Med. Sand</u>	<u>115'</u>	<u>148'</u>
		<u>148'</u>

WELL LOCATION:
 sec 29 T 7 N R 7 E
2 1/2 miles E of OCEAN SPRINGS
 (distance) (direction) (nearest town)

WELL PURPOSE: None
 (home, irrigation, municipal, industrial)

WELL COMPLETION DATA:

(1) diameter (inches) 2"

(2) total depth (feet) 150'

(3) static water level (feet) 20' ^{below} ~~above~~ top of ground.

(4) casing PVC, 140'
 (material) (depth)

2"
 (size) If telescope see back.

(5) screen 10', 140'
 (length) (depth to top)

2", PVC
 (size) (material)

(6) pump — (HP) — (yield gpm)

—
 (type power)

(7) electric log No
 (yes or no)

—
 (organization running log)


(8) how well bottom plugged
backfill with value

DRILLERS REMARKS:

1-8-84
pg. 20

If well telescopes please sketch and show depths.

GROUND LEVEL

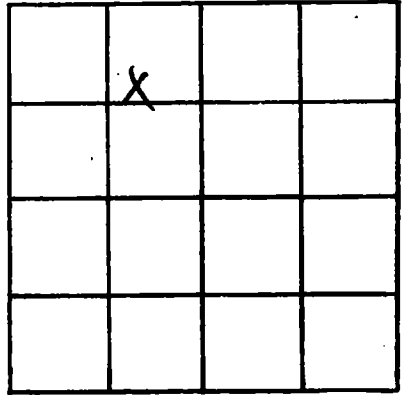

SECTION 29

Please indicate well location X.

ADDITIONAL INFORMATION

If more than one screen, show locations of each on sketch.