

MISSISSIPPI DEPARTMENT OF NATURAL RESOURCES

Bureau of Land and Water Resources

Southport Mall

P.O. Box 10631

Jackson, Mississippi 39209

WATER WELL DRILLERS LOG

Ø 2221  
 JACKSON  
 12-24-84

12-24-84 19 Cross Water Well Sew. Jackson  
 date well completed firm name county well located

Hard Planning Consultants Corp.  
 LANDOWNER:  
P.O. Box 26, Gautier,  
Miss. 39553  
 (mailing address)

WELL LOCATION:  
 sec. 18 T. 7 N. R. 7 E.  
3 miles NE of Spring  
 (distance) (direction) (nearest town)

WELL PURPOSE:  
 (home, irrigation, municipal, industrial)

WELL COMPLETION DATA:

(1) diameter (inches) 4"  
 (2) total depth (feet) 130'  
 (3) static water level (feet) 25' <sup>below</sup> <sub>above</sub> top of ground.  
 (4) casing PVC, 110',  
 (material) (depth)  
4" if telescope see back.  
 (size)  
 (5) screen 20', 110'  
 (length) (depth to top)  
4", PVC  
 (size) (material)  
 (6) pump 1, 20  
 (HP) (yield gpm)  
Elect.  
 (type power)  
 (7) electric log No  
 (yes or no)  
 (organization running log)  
 (8) has well bottom plugged Back Wash Valve

description of formations encountered	from	to
<u>Red Clay</u>	<u>0</u>	<u>5'</u>
<u>White Coarse sand</u>	<u>5'</u>	<u>35'</u>
<u>Blue Clay</u>	<u>35'</u>	<u>85'</u>
<u>Sand w/ Shale Clay</u>	<u>85'</u>	<u>100'</u>
<u>White Coarse sand</u>	<u>100'</u>	<u>130'</u>
		<u>142'</u>

RECEIVED


APR 2 - 1985

Department of Natural Resources  
 Bureau of Land & Water Resources

DRILLERS REMARKS:

If well telescopes please sketch and show depths.

GROUND LEVEL

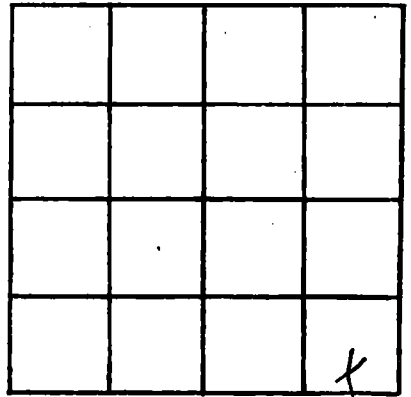

SECTION 18

Please indicate well location X.

ADDITIONAL INFORMATION

If more than one screen,  
show locations of each on sketch.