

MISSISSIPPI DEPARTMENT OF NATURAL RESOURCES

Bureau of Land and Water Resources

Southport Mall

P.O. Box 10631

Jackson, Mississippi 39209

WATER WELL DRILLERS LOG

0
 JACKSON 2270
 12-18-84

12-18 1984 date well completed
 Coast Water Well Sw. firm name
 Jackson county well located

LANDOWNER: Howard Doydater
 2706 Coakart
 San Antonio, Texas
 (mailing address) 78230

WELL LOCATION:
 sec. 36 T. 7 S. R. 7 E.
1N miles (distance) of Coakart (direction) of Coakart (nearest town)

WELL PURPOSE: home
 (home, irrigation, municipal, industrial)

WELL COMPLETION DATA:
 (1) diameter (inches) 2"
 (2) total depth (feet) 255'
 (3) static water level (feet) 40' ^{below}/_{above} top of ground
 (4) casing PVC, 245'
 (material) (depth)
2" if telescope see back.
 (size)
 (5) screen 10', 245'
 (length) (depth to top)
2", PVC
 (size) (material)
 (6) pump NONE
 (HP) (yield gpm)
elec.
 (type power)
 (7) electric log No
 (yes or no)
 (organization running log)
 (8) how well bottom plugged
Backward valve

description of formations encountered	from	to
<u>Sandy top soil</u>	<u>0</u>	<u>7</u>
<u>gray clay</u>	<u>7</u>	<u>52</u>
<u>Coarse Sand</u>	<u>52</u>	<u>65</u>
<u>gray clay</u>	<u>65</u>	<u>120</u>
<u>Coarse Sand</u>	<u>120</u>	<u>141</u>
<u>Blue clay</u>	<u>141</u>	<u>210</u>
<u>Med. Sand</u>	<u>210</u>	<u>255</u>


RECEIVED
 APR 2 1985

DRILLERS REMARKS:

Department of Natural Resources
 Bureau of Land & Water Resources

If well telescopes please sketch and show depths.

GROUND LEVEL

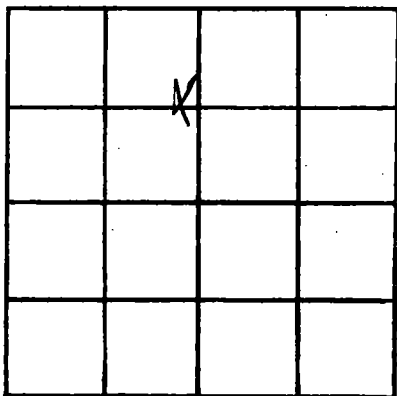

SECTION 36

Please indicate well location X.

ADDITIONAL INFORMATION

If more than one screen, show locations of each on sketch.