

MISSISSIPPI DEPARTMENT OF NATURAL RESOURCES

Bureau of Land and Water Resources

Southport Mall

P.O. Box 10631

Jackson, Mississippi 39209

WATER WELL DRILLERS LOG

0 2222
 JACKSON
 1-22-85

1-22-85 19 Crash Water Well Sew. Inc. Jackson
 date well completed firm name county well located

LANDOWNER: Edward Harvey
P.O. Box 818
Gautier, Miss. 39553
 (mailing address)

WELL LOCATION:
 sec. 9 T. 8 N. R. 7 E
3 miles SW of Gautier
 (distance) (direction) (nearest town)

WELL PURPOSE: None
 (home, irrigation, municipal, industrial)

WELL COMPLETION DATA:

(1) diameter (inches) 2"

(2) total depth (feet) 70'

(3) static water level (feet) 8' below top of ground. above

(4) casing PVC, 60', CL
 (material) (depth)
2" if telescope see back.
 (size)

(5) screen 10', 60'
 (length) (depth to top)

1 1/2", PVC
 (size) (material)

(6) pump 1 hp., 15
 (HP) (yield gpm)

Electric
 (type power)

(7) electric log No
 (yes or no)

(organization running log)

(8) how well bottom plugged Back wash valve

description of formations encountered	from	to
<u>Top soil</u>	<u>0</u>	<u>2'</u>
<u>Sand</u>	<u>2</u>	<u>5'</u>
<u>Blue Clay</u>	<u>5</u>	<u>58'</u>
<u>White coarse sand</u>	<u>50'</u>	<u>70'</u>
<u>10' PVC Tail Pipe</u>		<u>None</u>


RECEIVED
 APR 2 - 1985

Department of Natural Resources
 Bureau of Land & Water Resources

DRILLERS REMARKS: _____

If well telescopes please sketch and show depths.

GROUND LEVEL

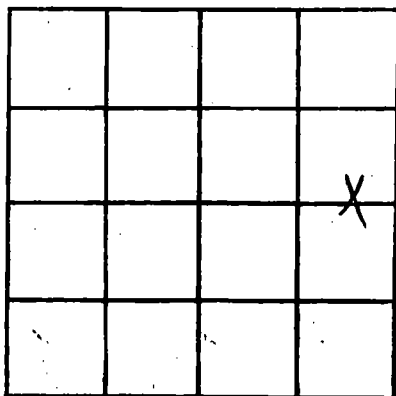

SECTION 9

Please indicate well location X.

ADDITIONAL INFORMATION

If more than one screen, show locations of each on sketch.