

JACKSON  
Q 2225

MISSISSIPPI DEPARTMENT OF NATURAL RESOURCES  
Bureau of Land and Water Resources  
Southport Mall  
P.O. Box 10631  
Jackson, Mississippi 39209  
WATER WELL DRILLERS LOG

2-21-85 19 Coash Water Well Sew. Jackson  
date well completed firm name county well located

Howard Construction Co.  
LANDOWNER  
2303 Parsley Ave.  
Pascagoula, Miss.  
(mailing address) 39367

description of formations encountered	from	to
Top soil	0	3'
Red Clay	3	20'
Blue Clay	20'	25'
Blue Clay (Ship sand)	55'	105'
Coarse white sand	105'	129'
Blue Clay	129'	147'
Coarse white sand	147'	265'
Blue Clay	265'	280'
Med Clay sand	280'	320'
Blue Clay	320'	344'
Blue Clay (Ship sand)	344'	387'
Blue Clay (shell) sand	387'	440'
Med sand	440'	460'
Coarse sand - gravel	460'	510'
		460'

WELL LOCATION:  
sec. 26 T. 7 N. R. 7 E.  
IN miles of GAULTON  
(distance) (direction) (nearest town)

WELL PURPOSE:  
(home, irrigation, municipal, industrial)

WELL COMPLETION DATA:  
(1) diameter (inches) 2"  
(2) total depth (feet) 510'  
(3) static water level (feet) 35' (below top of ground)  
(4) casing PVC, 490' (material) (depth)  
2" If telescope see back. (size)  
(5) screen 20' (length), 490' (depth to top)  
2" PVC (size) (material)  
(6) pump (HP) (yield gpm)  
(type power)  
(7) electric log No (yes or no)  
(organization running log)  
(8) how well bottom plugged Back wash valve


DRILLERS REMARKS:

RECEIVED  
JUL 10 1985

Department of Natural Resources  
Bureau of Land & Water Resources

If well telescopes please sketch and show depths.

GROUND LEVEL

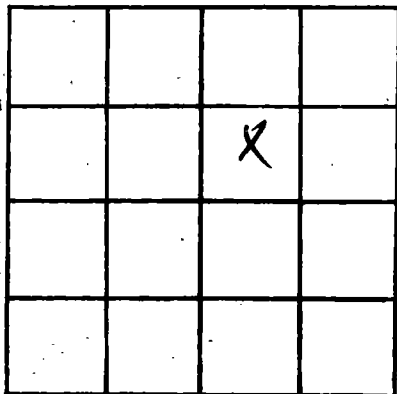

SECTION 26

Please indicate well location X.

ADDITIONAL INFORMATION

If more than one screen,  
show locations of each on sketch.