

MISSISSIPPI DEPARTMENT OF NATURAL RESOURCES

Bureau of Land and Water Resources

Southport Mall

P.O. Box 10631

Jackson, Mississippi 39209

WATER WELL DRILLERS LOG

JACKSON

Q 2226

4-8-

19

85 Coast Water Well Sew. Jackson

date well completed

firm name

county well located

LANDOWNER:

Clayton Mc Cain

description of formations encountered

from

to

2415 Embury Grande

Top soil

0 3'

Gautier, Miss.

Blue Clay

3' 43'

(mailing address) 375 S. 3

base white sand

43' 80'

WELL LOCATION:

sec 38 T 7 N R 7 E S W  
3 miles WEST of GAUTIER  
(distance) (direction) (nearest town)

Blue Clay

80' 107'

Fine sand

107' 145'

WELL PURPOSE:

None

(home, irrigation, municipal, industrial)

Blue Clay

145' 236'

WELL COMPLETION DATA:

Fine sand

236' 260'

(1) diameter (inches) 2"

Blue Clay

260' 268'

(2) total depth (feet) 282'

base gray sand

268' 282'

(3) static water level (feet) 30' below top of ground

(4) casing PVC 272' (material) (depth)

2" (size) If telescope see back.

(5) screen 10' 272' (length) (depth to top)

2" PVC (size) (material)

(6) pump 1 h.p. 12 (HP) (yield gpm)

Electric (type power)

(7) electric log No (yes or no)

(organization running log)

(8) has well bottom plugged Back hook valve

DRILLERS REMARKS:


RECEIVED

JUL 10 1995

Department of Natural Resources  
Bureau of Land & Water Resources

If well telescopes please sketch and show depths.

GROUND LEVEL

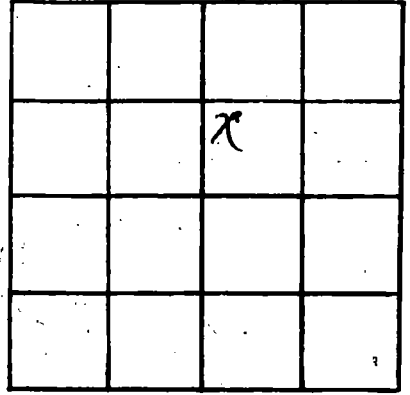

SECTION 38

Please indicate well location X.

ADDITIONAL INFORMATION

Lined area for additional information.

If more than one screen, show locations of each on sketch.