

MISSISSIPPI DEPARTMENT OF NATURAL RESOURCES

Bureau of Land and Water Resources

Southport Mall

P.O. Box 10631

Jackson, Mississippi 39209

WATER WELL DRILLERS LOG

Jackson
 2230
 4-19-85

L

4-19-85 date well completed
 19 Coast Water Well Sew. firm name
 Jackson county well located

LANDOWNER: A.S. Whitehead
 3704 Beth Terrace
 Gautier, Miss. 39553
 (mailing address)

WELL LOCATION:
 sec. 36 T. 7 S. R. 7 W.
 IN miles of GAUTIER
 (distance) (direction) (nearest town)

WELL PURPOSE: Home
 (home, irrigation, municipal, industrial)

WELL COMPLETION DATA:
 (1) diameter (inches) 2"
 (2) total depth (feet) 300'
 (3) static water level (feet) 20' below top of ground
 (4) casing PVC, 290' (depth)
 2" (size) if telescope see back.
 (5) screen 10' (length), 290' (depth to top)
 2" (size) PVC (material)
 (6) pump 1 1/2 HP, 13 (yield gpm)
 Elect. (type power)
 (7) electric log No (yes or no)
 (organization running log)
 (8) how well bottom plugged: Duck Wash Valve

description of formations encountered	from	to
Top soil	0'	4'
Blue Clay	4'	35'
Gray Coarse sand	35'	60'
Gray Coarse sand & silt	60'	90'
Gray Coarse sand	90'	117'
Blue Clay	117'	125'
Gray Coarse sand	125'	150'
Blue Clay	150'	183'
Gray Coarse sand	183'	295'
Blue Clay	295'	300'
		Hole


RECEIVED
 JUL 11 1985

Department of Natural Resources
 Bureau of Land & Water

DRILLERS REMARKS:

If well telescopes please sketch and show depths.

GROUND LEVEL

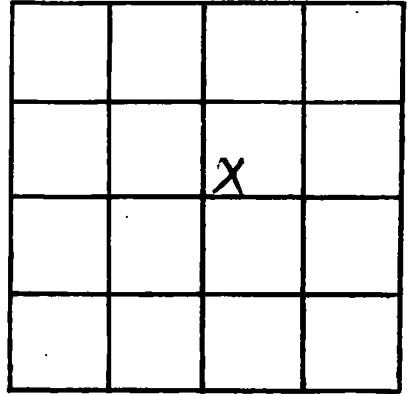

SECTION 36

Please indicate well location X.

ADDITIONAL INFORMATION

If more than one screen,
show locations of each on sketch.