

MISSISSIPPI DEPARTMENT OF NATURAL RESOURCES

Bureau of Land and Water Resources

Southport Mall

P.O. Box 10631

Jackson, Mississippi 39209

WATER WELL DRILLERS LOG

Jackson  
 O 2232  
 5-10-85

5-10-85 date well completed  
 Coast Water Well Sew. firm name  
 Jackson county well located

LANDOWNER: E.C. Freeman  
 Rt 7, Box 263-F  
 Ocean Springs, Miss.  
 (mailing address) 37624

WELL LOCATION:  
 sec. 18 T. 81 N. R. 7 E.  
 5 70 SE of Springs  
 (distance) miles (direction) (nearest town)

WELL PURPOSE:  
 (home, irrigation, municipal, industrial)

WELL COMPLETION DATA:  
 (1) diameter (inches) 2"  
 (2) total depth (feet) 460'  
 (3) static water level (feet) 35' below top of ground  
 (4) casing PVC 440' (material), (depth)  
 2" (size) if telescope see back.  
 (5) screen 20' (length), 440' (depth to top)  
 2" (size) PVC (material)  
 (6) pump 1 h.p. 10k (HP), (yield gpm)  
 Elec. (type power)  
 (7) electric log No (yes or no)  
 (organization running log)  
 (8) how well bottom plugged  
 Lock wash valve

description of formations encountered	from	to
Sand	0	10'
Clay	10'	15'
Sand	15'	85'
Blue Clay	85'	190'
Coarse sand	190'	225'
Blue Clay	225'	320'
Blue Clay, clay sand	320'	365'
Blue Clay	365'	405'
Coarse pebbly sand	405'	460'


RECEIVED  
 JUL 11 1985

DRILLERS REMARKS:

Department of Natural Resources  
 Bureau of Land & Water Resources

If well telescopes please sketch and show depths.

GROUND LEVEL

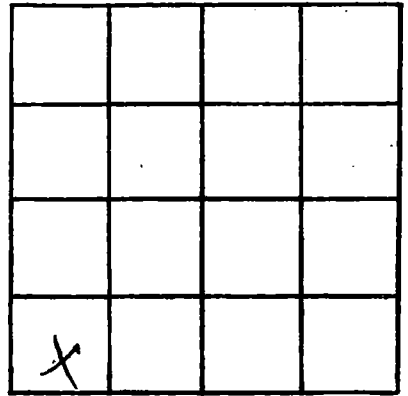

SECTION 18

Please indicate well location X.

ADDITIONAL INFORMATION

If more than one screen, show locations of each on sketch.