

MISSISSIPPI DEPARTMENT OF NATURAL RESOURCES

Bureau of Land and Water Resources

Southport Mall

P.O. Box 10631

Jackson, Mississippi 39209

WATER WELL DRILLERS LOG

JACKSON
 2234

5-21-85 85 Coast Water Well Sew. Jackson

date well completed

firm name

county well located

LANDOWNER:

Description of formations encountered

from

to

1321 Old Lee Road
 Theodore, Ala. 36582
 (mailing address)

Top soil
 0 3'
 White sand
 3' 10'

WELL LOCATION:

sec. 36 T. 7 S. R. 7 E.
 IN miles of GAUTIER
 (distance) (direction) (nearest town)

Blue Clay 10' 45'
 Blue Clay & Chert shell 45' 60'
 Gray coarse sand 60' 75'

WELL PURPOSE:

(home, irrigation, municipal, industrial)

Blue Clay and wood 75' 90'

WELL COMPLETION DATA:

- (1) diameter (inches) 5"
- (2) total depth (feet) 300'
- (3) static water level (feet) 46' ^{below} _{above} top of ground
- (4) casing (material) PVC (depth) 290' c
- 2" (size) if telescope see back.
- (5) screen 10' (length) 290' (depth to top)
- 2" (size) PVC (material)
- (6) pump 1 h.p. (HP) 9 (yield gpm)
- Elect. (type power)
- (7) electric log No (yes or no)

Blue Clay & shell sand 90' 120'
 Gray coarse sand 120' 135'
 Gray coarse sand & wood 135' 175'
 Blue Clay 175' 180'
 Gray coarse sand 180' 195'
 Gray coarse sand & gravel 195' 300'

5" Tail Pipe

(organization running log)

(8) how well bottom plugged Back Wash Valve


RECEIVED
 JUL 10 1985

DRILLERS REMARKS:

Department of Natural Resources
 Bureau of Land & Water Resources

If well telescopes please sketch and show depths.

GROUND LEVEL

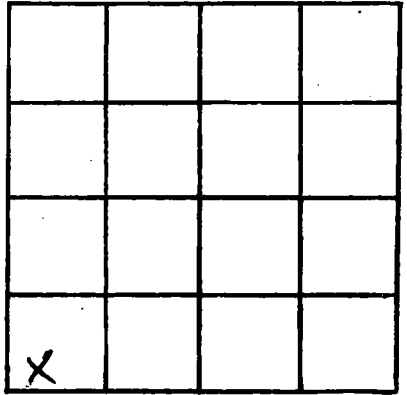

SECTION 36

Please indicate well location X.

ADDITIONAL INFORMATION

If more than one screen, show locations of each on sketch.