

MISSISSIPPI DEPARTMENT OF NATURAL RESOURCES

Bureau of Land and Water Resources

Southport Mall

P.O. Box 10631

Jackson, Mississippi 39209

WATER WELL DRILLERS LOG

JACKSON
 0 2235

6-21-85 19 date well completed
 Coast Water Well Serv. firm name
 Jackson county well located

LANDOWNER: Linda Meyer
3821 Sherrock Ct.
Gautier, Miss. 39553
 (mailing address)

WELL LOCATION:
 sec. 36 T 2 S R 7 E
IN miles of GAUTIER
 (distance) (direction) (nearest town)

WELL PURPOSE: Home
 (home, irrigation, municipal, industrial)

WELL COMPLETION DATA:

- (1) diameter (inches) 2"
- (2) total depth (feet) 297'
- (3) static water level (feet) 23' below top of ground.
- (4) casing PVC, 287' (depth)
2" (size) if telescope see back.
- (5) screen 10' (length), 287' (depth to top)
2" (size), PVC (material)
- (6) pump _____ (HP) _____ (yield gpm)
 _____ (type power)
- (7) electric log No (yes or no)
 _____ (organization running log)
- (8) how well bottom plugged fish wash valve

description of formations encountered	from	to
Top soil	0	2'
Red & Gray Clay	2'	7'
Blue Clay	7'	12'
Gray Coarse sand	12'	40'
Blue Clay	40'	45'
Gray Coarse sand	45'	57'
Blue Clay & Shell of sand	57'	125'
Gray Coarse sand	125'	140'
Blue Clay	140'	180'
Gray Coarse sand	180'	294'
Blue Clay	294'	297'
5 1/2" Test Pipe		hole
	287	
	10	
	297	

RECEIVED


NOV - 1 1985

DRILLERS REMARKS:

Department of Natural Resources
 Bureau of Land & Water Resources

If well telescopes please sketch and show depths.

GROUND LEVEL

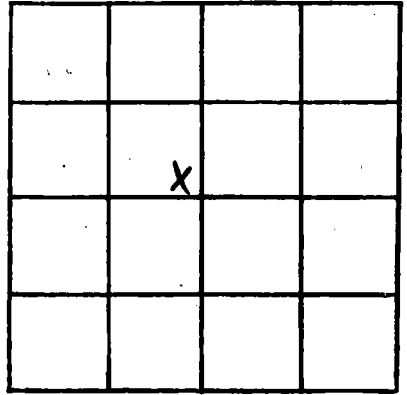

SECTION 36

Please indicate well location X.

ADDITIONAL INFORMATION

If more than one screen, show locations of each on sketch.