

MISSISSIPPI DEPARTMENT OF NATURAL RESOURCES

Bureau of Land and Water Resources

Southport Mall

P.O. Box 10631

Jackson, Mississippi 39209

WATER WELL DRILLERS LOG

Jackson  
D 2236

6-24-83  
date well completed

Coast Water Well Sew. Jackson  
firm name county well located

LANDOWNER

A. Stays  
3837 Shamrock Ct.  
Gautier Miss.  
(mailing address)

description of formations encountered

from to

WELL LOCATION:

sec 36 T 2 S R 2 E  
IN miles of GAUTIER  
(distance) (direction) (nearest town)

Top soil	0	1'
Coarse red sand	1'	5'
Red Clay	5'	10'
Coarse white sand	10'	16'
Blue Clay	16'	18'
Coarse gray sand	18'	40'
Blue Clay	40'	45'
Coarse gray sand	45'	60'

WELL PURPOSE:

Home  
(home, irrigation, municipal, industrial)

WELL COMPLETION DATA:

- (1) diameter (inches) 2"
- (2) total depth (feet) 60'
- (3) static water level (feet) 38' <sup>below</sup> <sub>above</sub> top of ground.
- (4) casing PVC, 50' <sub>(material)</sub> <sub>(depth)</sub> CL  
2" if telescope see back.  
<sub>(size)</sub>
- (5) screen 10', 50' <sub>(length)</sub> <sub>(depth to top)</sub>  
2", PVC <sub>(size)</sub> <sub>(material)</sub>
- (6) pump 1, 11 <sub>(HP)</sub> <sub>(yield gpm)</sub>  
Elect <sub>(type power)</sub>
- (7) electric log No <sub>(yes or no)</sub>

(organization running log)

(8) how well bottom plugged  
Jack Wash Valve


RECEIVED

NOV - 1 1985

DRILLERS REMARKS:

If well telescopes please sketch and show depths.

GROUND LEVEL

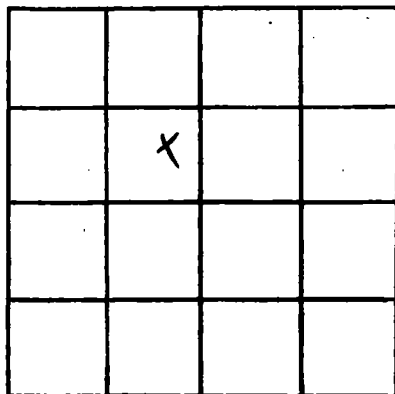

SECTION 36

Please indicate well location X.

ADDITIONAL INFORMATION

If more than one screen,  
show locations of each on sketch.