

MISSISSIPPI DEPARTMENT OF NATURAL RESOURCES

Bureau of Land and Water Resources

Southport Mall

P.O. Box 10631

Jackson, Mississippi 39209

WATER WELL DRILLERS LOG

JACKSON
 \$2237

9-20-85 date well completed
 Coast Water Well Sew. firm name
 Jackson county well located

LANDOWNER: Jim Posey
 further location: Rte. 39533
 (mailing address)

description of formations encountered	from	to
Top soil	0	5'
Blue Clay	5'	30'
Coarse sand	30'	55'
Coarse sand & pea gravel	55'	100'

WELL LOCATION:
 sec. 26 T. 7 N. R. 7 E.
 IN (distance) miles (direction) of GAULIER (nearest town)

WELL PURPOSE: Home
 (home, irrigation, municipal, industrial)

- WELL COMPLETION DATA:
- (1) diameter (inches) 2"
 - (2) total depth (feet) 100'
 - (3) static water level (feet) 12' below top of ground.
 - (4) casing PVC 4.5' (material) (depth)
 - 2" (size) if telescope see back.
 - (5) screen 10' 45' (length) (depth to top)
 - 2" PVC (size) (material)
 - (6) pump 1/2 hp 8 1/2 (HP) (yield gpm)
 - check (type power)
 - (7) electric log No (yes or no)
 - (organization running log)
 - (8) has well bottom plugged Back Wash Valve

45
 will 85

RECEIVED


NOV - 4 1985

DRILLERS REMARKS:
 5-7" Tail Pipe -
 Check Catcher.

Department of Natural Resources
 Bureau of Land & Water Resources

If well telescopes please sketch and show depths.

GROUND LEVEL

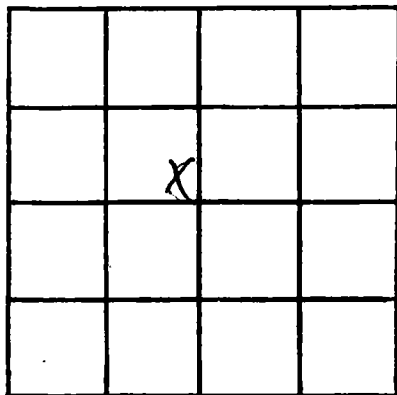

SECTION 26

Please indicate well location X.

ADDITIONAL INFORMATION

If more than one screen,
show locations of each on sketch.