

MISSISSIPPI DEPARTMENT OF NATURAL RESOURCES

Bureau of Land and Water Resources

Southport Mall

P.O. Box 10631

Jackson, Mississippi 39209

WATER WELL DRILLERS LOG

JACKSON  
 2238

Sept. 13, 1985, Coon water well Jackson  
 date well completed firm name county well located

LANDOWNER: Frank Eaton  
Rt 7, Box 230,  
Ocean Springs, Miss  
 (mailing address) 39564

WELL LOCATION:  
 sec. 38 T. 7 N. R. 7 E  
3 miles W of GAUTIER  
 (distance) (direction) (nearest town)

WELL PURPOSE: None  
 (home, irrigation, municipal, industrial)

WELL COMPLETION DATA:

(1) diameter (inches) 2"

(2) total depth (feet) 510'

(3) static water level (feet) 51' <sup>(below)</sup> <sub>(above)</sub> top of ground.

(4) casing PVC 495' CL  
 (material) (depth)  
2" If telescope see back.  
 (size)

(5) screen 10' 495'  
 (length) (depth to top)  
2" PVC  
 (size) (material)

(6) pump 1/2 hp. 10  
 (HP) (yield gpm)  
Elect.  
 (type power)

(7) electric log no  
 (yes or no)  
\_\_\_\_\_  
 (organization running log)

(8) how well bottom plugged Backwash valve

description of formations encountered	from	to
Top Soil	0'	3'
Blue Clay	3'	10'
White Medium sand	10'	20'
Blue Clay	20'	50'
White Coarse sand	50'	70'
White Coarse sand + Gravel	70'	75'
Blue Clay	75'	120'
White Coarse Sand	120'	155'
Blue Clay	155'	177'
White Coarse Sand	177'	190'
Blue Clay	190'	477'
Gray Coarse Sand	477'	510'


RECEIVED  
 will 505  
 695V - 4 1985  
 10

Department of Natural Resources  
 Bureau of Land & Water Resources

DRILLERS REMARKS:  
5'-2" PVC tail pipe

If well telescopes please sketch and show depths.

GROUND LEVEL

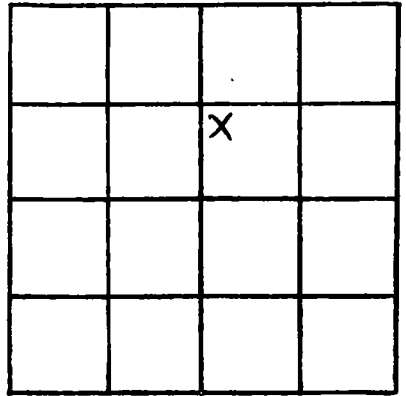

SECTION 38

Please indicate well location X.

ADDITIONAL INFORMATION

If more than one screen, show locations of each on sketch.