

MISSISSIPPI DEPARTMENT OF NATURAL RESOURCES

Bureau of Land and Water Resources

Southport Mall

P.O. Box 10631

Jackson, Mississippi 39209

WATER WELL DRILLERS LOG

JACKSON
D 2239

10-9-1985 Coast Water Well Sew Jackson
date well completed firm name county well located

LANDOWNER: Billy Cox
2816 Roxton
Sulphur La. 70663
(mailing address)

WELL LOCATION:
sec. 18 T-7 N R-7 E
3 miles NE of OCEAN SPRINGS
(distance) (direction) (nearest town)

WELL PURPOSE: Home
(home, irrigation, municipal, industrial)

WELL COMPLETION DATA:
(1) diameter (inches) 2"
(2) total depth (feet) 521'
(3) static water level (feet) 34' ^{below} top of ground
(4) casing PVC 501'
(material) (depth)
2 If telescope see back.
(size)
(5) screen 10' 501'
(length) (depth to top)
2" PVC
(size) (material)
(6) pump 1/2 HP 11
(HP) (yield gpm)
Electric
(type power)
(7) electric log No
(yes or no)
(organization running log)


description of formations encountered	from	to
Top soil	0	2'
Blue Clay & wood	2'	18'
White coarse sand	18'	22'
Blue Clay	22'	54'
White coarse sand & wood	54'	90'
Blue Clay	90'	390'
Blue Clay & shell of sand	390'	440'
Gray fine sand	440'	451'
Gray Med sand	451'	475'
Gray coarse sand	475'	512'
Gray coarse sand and wood	512'	521'

well still

(8) how well bottom plugged
Backwash Valve

DRILLERS REMARKS:
10' - 2" Tail Pipe
Shell Catcher

RECEIVED
NOV 26 1985

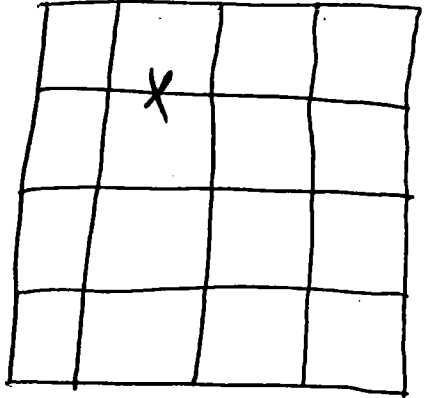

SECTION 18