

MISSISSIPPI DEPARTMENT OF NATURAL RESOURCES

Bureau of Land and Water Resources

Southport Mall

P.O. Box 10631

Jackson, Mississippi 39209

WATER WELL DRILLERS LOG

JACKSON  
 09240

10-9-85

Coast Water Well Sew. Jackson

date well completed

firm name

county well located

LANDOWNER:

George Koppel

description of formations encountered

from

to

6008 Allen Rd

Top soil

0 2'

Ocean Springs MS  
 (mailing address) 39067

Brown Clay

2 15'

WELL LOCATION:

sec. 8 T. 7 N. R. 7 E  
 3 1/2 miles NE of Ocean Springs  
 (distance) (direction) (nearest town)

Blue Clay

15' 30'

White Coarse sand

30' 45'

Blue Clay

45' 60'

WELL PURPOSE:

(home, irrigation, municipal, industrial)

Home

White Coarse sand

60' 115'

WELL COMPLETION DATA:

(1) diameter (inches) 2"

Shed of Blue Clay

115' 135'

(2) total depth (feet) 238'

Gray Med sand

135' 155'

(3) static water level (feet) 15' below top of ground.

Blue Clay

155' 160'

(4) casing PVC 224' (material) (depth)

Gray Med sand

160' 195'

2" (size) if telescope see back.

Gray coarse sand

195' 234'

(5) screen 10' 224' (length) (depth to top)

Blue Clay

234' 238'

2" (size) PVC (material)

well 234'

(6) pump 1/2 hp. 1.3 (HP) (yield gpm)

Elect. (type power)

(7) electric log No (yes or no)

(organization running log)

(8) how well bottom plugged  
 Jack Wash Valve

RECEIVED

NOV 26 1985


DRILLERS REMARKS:

1-4" Tail Pipe  
 1-Shell Catcher

Department of Natural Resources  
 Bureau of Land & Water Resources

If well telescopes please sketch and show depths.

GROUND LEVEL

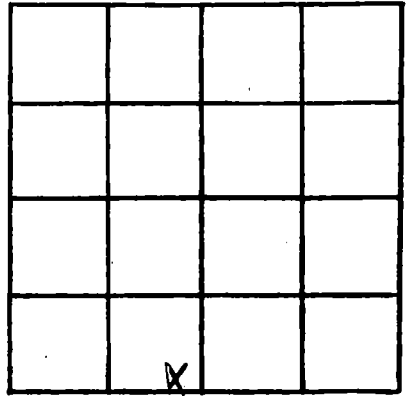

SECTION 8

Please indicate well location X.

ADDITIONAL INFORMATION

If more than one screen, show locations of each on sketch.