

MISSISSIPPI DEPARTMENT OF NATURAL RESOURCES

Bureau of Land and Water Resources

Southport Mall

P.O. Box 10631

Jackson, Mississippi 39209

WATER WELL DRILLERS LOG

Jackson  
 #2241

12-5-81 date well completed 19 Coast Water Well Sew. firm name Jackson county well located

LANDOWNER	description of formations encountered	from	to
1512 Bayou Vista Dr Gautier, Ms. (mailing address) 39543	Top soil	0	1'
	Blue Clay	1'	118'

WELL LOCATION:  
 sec. 36 T. 1 N. R. 7 E.  
 IN miles (distance) of GAUTIER (nearest town)

WELL PURPOSE: home  
 (home, irrigation, municipal, industrial)

WELL COMPLETION DATA:

(1) diameter (inches) 2"

(2) total depth (feet) 305'

(3) static water level (feet) 27' below top of ground

(4) casing (material) PVC (depth) 280' CL

2" (size) if telescope see back.

(5) screen (length) 10' (depth to top) 280'

2" (size) PVC (material)

(6) pump (HP) (yield gpm)

Electric (type power)



(7) electric log No (yes or no)

(organization running log)

(8) how well bottom plugged  
 Check Wash Valve

description of formations encountered	from	to
Struck Sand		
Blue Clay	118'	125'
White Coarsesand	125'	180'
Blue Clay	180'	210'
Gray Med. Sand	210'	305'
		Hole

well 290

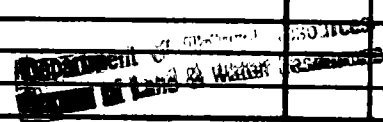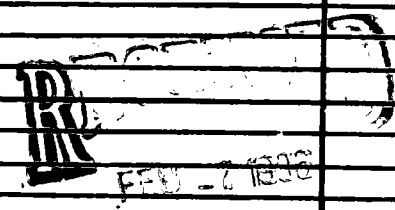

DRILLERS REMARKS:  
 1 - Shovel Catcher  
 15' - 2" PVC Tail Pipe

