

MISSISSIPPI DEPARTMENT OF NATURAL RESOURCES

Bureau of Land and Water Resources

Southport Mall

P.O. Box 10631

Jackson, Mississippi 39209

WATER WELL DRILLERS LOG

Jackson
 #29492

12-11-85 19 Copied Water Well Sewer. Jackson
 date well completed firm name county well located

LANDOWNER Jack Ridgell
P.O. Box 581, Gautier, MS.
Gautier, MS. 39553
 (mailing address)

description of formations encountered	from	to
Top soil	0	1'
Blue Clay	1'	43'
Blue Clay w/ streak		
10' sand	43'	60'
White Base sand	60'	75'
Blue Clay	75'	100'
Medium sand	100'	115'
Blue Clay	115'	161'
Med. gray Base sand	161'	300'

WELL LOCATION:
 sec 36 T 7 N R 7 W
IN miles (distance) of GAUTIER (nearest town)

WELL PURPOSE: Home
 (home, irrigation, municipal, industrial)

WELL COMPLETION DATA:
 (1) diameter (inches) 2"
 (2) total depth (feet) 300
 (3) static water level (feet) 20' below top of ground.
 (4) casing PVC 275'
 (material) (depth)
2" if telescope see back.
 (size)
 (5) screen 20' 275'
 (length) (depth to top)
2" PVC
 (size) (material)
 (6) pump 1 10
 (HP) (yield gpm)
elect.
 (type power)
 (7) electric log No
 (yes or no)
 (organization running log)


(8) no well bottom plugged
Shed block blue

DRILLERS REMARKS:
5' - 2" Tail Pipe
1' - Shed Catcher

well 275

If well telescopes please sketch and show depths.

GROUND LEVEL

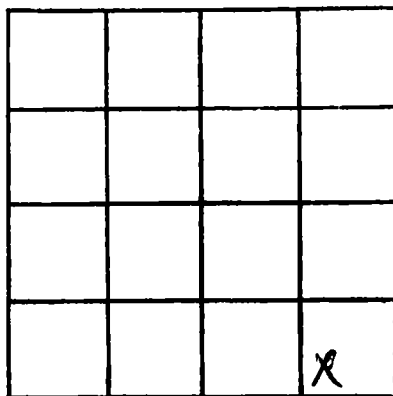

SECTION 36

Please indicate well location X.

ADDITIONAL INFORMATION

If more than one screen,
show locations of each on sketch.