

MISSISSIPPI DEPARTMENT OF NATURAL RESOURCES

Bureau of Land and Water Resources

Southport Mall

P.O. Box 10631

Jackson, Mississippi 39209

WATER WELL DRILLERS LOG

JACKSON
 02243

12-23-1983 date well completed
 Coast Water Well Sew firm name
 Jackson county well located

LANDOWNER: Mr. James Lee
Hwy 90
Gautier Miss.
 (mailing address) 39533

WELL LOCATION:
 sec. 26 T. 7 S. R. 2 W.
1N miles (distance) of GAUTIER (nearest town)

WELL PURPOSE: Industrial
 (home, irrigation, municipal, industrial)

WELL COMPLETION DATA:
 (1) diameter (inches) 4 1/2"
 (2) total depth (feet) 508
 (3) static water level (feet) 55 below top of ground.
 (4) casing PVC (material), 488' (depth)
4 1/2" (size) if telescope see back.
 (5) screen 20 (length), 488' (depth to top)
4 1/2" (size), PVC (material)
 (6) pump 1 (HP), 18 (yield gpm)
elect. (type power)
 (7) electric log No (yes or no)
 (organization running log)
 (8) how well bottom plugged


description of formations encountered	from	to
Red Sand	0	3'
Brown Clay	3'	10'
Blue Clay	10'	14'
White Coarse sand	14'	50'
White Coarse sand w/ gravel	50'	59'
Blue Clay	59'	128'
Med. sand	128'	140'
Blue Clay	140'	165'
Gray Coarse sand	165'	268'
Blue Clay	268'	285'
Med to fine sand	285'	300'
Blue Clay	300'	460'
Gray Coarse sand	460'	508'

RECEIVED
 Bureau of Land & Water Resources
 11/26/83

DRILLERS REMARKS:
5' overlap
3-Shell Catcher

If well telescopes please sketch and show depths.

GROUND LEVEL

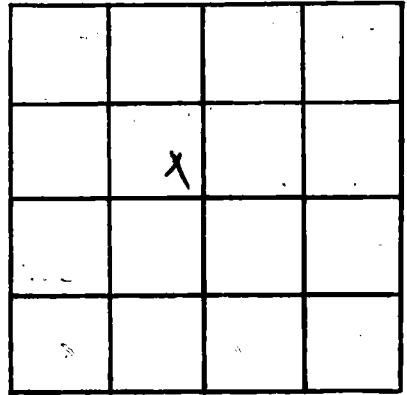

SECTION 26

Please indicate well location X.

ADDITIONAL INFORMATION

If more than one screen,
show locations of each on sketch.