

MISSISSIPPI DEPARTMENT OF NATURAL RESOURCES

Bureau of Land and Water Resources

Southport Mall

P.O. Box 10631

Jackson, Mississippi 39209

WATER WELL DRILLERS LOG

Jackson
Φ 2246

Jan 21 - 1986 Coastwater well Jackson
 date well completed firm name county well located

LANDOWNER: Ronald Tully
1011 14th St.
Pascagoula ms
 (mailing address) 39501

WELL LOCATION:
 sec. 36 T. 7 S. R. 7 E.
1N miles — of GAUTIER
 (distance) (direction) (nearest town)

WELL PURPOSE: Home
 (home, irrigation, municipal, industrial)

WELL COMPLETION DATA:

(1) diameter (inches) 2"

(2) total depth (feet) 301

(3) static water level (feet) 20 ^{below} _{top of ground}

(4) casing PVC 286'
 (material) (depth)
2"
 (size) if telescope see back.

(5) screen 10' 286'
 (length) (depth to top)
2" PVC
 (size) (material)

(6) pump 1/2 HP 11
 (HP) (yield gpm)
Elmer
 (type power)

(7) electric log no
 (yes or no)

(organization running log)

(8) how well bottom plugged Backwash valve

description of formations encountered	from	to
Top Soil	0	3
Blue Clay	3	18
white coarse sand	18	31
Blue Clay	31	60
white coarse sand	60	65
Blue Clay	65	90
Gray Coarse sand + wood	90	128
Blue Clay + streak of sand	128	175
Blue Clay	175	186
Gray Coarse sand	186	298
Blue Clay	298	301


RECEIVED
 MAR 6 - 1986

DRILLERS REMARKS:
5' 2" tail pipe

Department of Natural Resources
 Bureau of Land & Water Resources

If well telescopes please sketch and show depths.

GROUND LEVEL

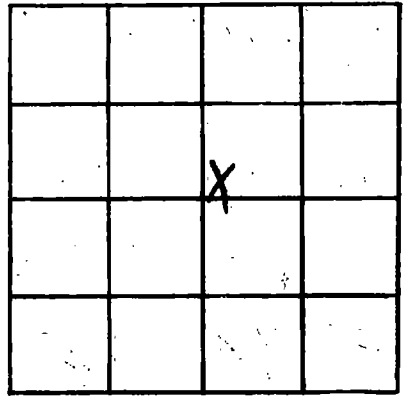

SECTION 36

Please indicate well location X.

ADDITIONAL INFORMATION

If more than one screen, show locations of each on sketch.