

MISSISSIPPI DEPARTMENT OF NATURAL RESOURCES

Bureau of Land and Water Resources

Southport Mall

P.O. Box 10631

Jackson, Mississippi 39209

WATER WELL DRILLERS LOG

Jackson
 2247

3-4-80 1980 date well completed
 Coast Water Well Service firm name
 Jackson county well located

LANDOWNER: Marion Cummings
 3329 Old Spanish Trail
 GAULIER MS 39553
 (mailing address)

WELL LOCATION:
 sec 34 T 7 R 7
 1 miles West of GAULIER
 (distance) (direction) (nearest town)

WELL PURPOSE: home
 (home, irrigation, municipal, industrial)

WELL COMPLETION DATA:
 (1) diameter (inches) 2"
 (2) total depth (feet) 340'
 (3) static water level (feet) 45' below top of ground
 (4) casing PVC, 515'
 (material) (depth)
 2" (size) If telescope see back.
 (5) screen 20', 515'
 (length) (depth to top)
 2" PVC
 (size) (material)
 (6) pump _____
 (HP) (yield gpm)
 (type power)
 (7) electric log no
 (yes or no)
 P
 (organization running log)
 (8) no well bottom plugged

description of formations encountered	from	to
cap sand	0	1
Red sand	1	4
Blue Clay	4	60
white coarse sand	60	75
Blue Clay	75	90
white coarse sand	90	152
Blue Clay	152	174
white coarse sand	174	327
Blue Clay	327	490
med Gray sand	490	540

515
 20'
 well 535


RECEIVED
 MAY 12 1980

Department of Natural Resources
 Bureau of Land & Water Resources

DRILLERS REMARKS:
 5-2" PVC tail pipe

If well telescopes please sketch and show depths.

GROUND LEVEL

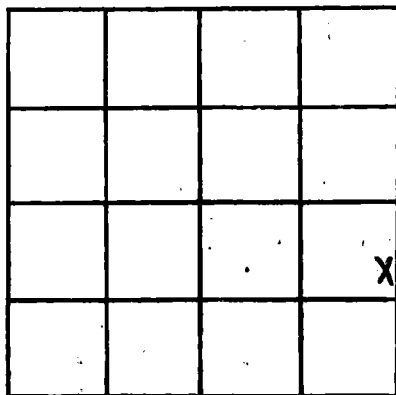

SECTION _____

Please indicate well location X.

ADDITIONAL INFORMATION

If more than one screen, show locations of each on sketch.