

MISSISSIPPI DEPARTMENT OF NATURAL RESOURCES

Bureau of Land and Water Resources

Southport Mall

P.O. Box 10631

Jackson, Mississippi 39209

WATER WELL DRILLERS LOG

Jackson
 Φ 2248

3-8-86
 date well completed

Coastwater Well Svc
 firm name

Jackson
 county well located

LANDOWNER: Jim Posey
P.O. Box 1685
Pascagoula, Ms. 39367
 (mailing address)


WELL LOCATION:
 sec 26 T 7 N R 2 E
1 miles (distance) W (direction) of GAUTIER (nearest town)

WELL PURPOSE: Individual
 (home, irrigation, municipal, industrial)

WELL COMPLETION DATA:

- (1) diameter (inches) 4x2
 - (2) total depth (feet) 510
 - (3) static water level (feet) 65 ^{Below} _{above} top of ground.
 - (4) casing PVC (material) 240' (depth) 4" (size) 4x2" If telescope see back.
 - (5) screen 20' (length) 485' (depth to top) 2" (size) PVC (material)
 - (6) pump 1 (HP) 18 (yield gpm) Elect (type power)
 - (7) electric log no (yes or no)
- (organization running log)
- (8) How well bottom plugged Backwash valve

description of formations encountered	from	to
Top Soil	0	2
Blue Clay	2	14
White Coarse Sand	14	20
Blue Clay	20	29
White Coarse Sand	29	60
Blue Clay	60	105
White Coarse Sand	105	135
Blue Clay	135	150
Gray Coarse Sand	150	280
Blue Clay	280	290
Gray Med Sand	290	300
Blue Clay	300	460
Gray Med Sand	460	508
Blue Clay	508	510

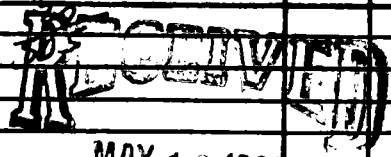

MAY 12 1986

Department of Natural Resources
 Bureau of Land & Water Resources

DRILLERS REMARKS: 5'-2" tailpipe

