

MISSISSIPPI DEPARTMENT OF NATURAL RESOURCES

Bureau of Land and Water Resources

Southport Mall

P.O. Box 10631

Jackson, Mississippi 39209

WATER WELL DRILLERS LOG

Jackson
 02249

9-18-86 19 Coastal water well Dr. Jackson
 date well completed firm name county well located

LANDOWNER: Kenneth M...
 6000 ALLEN ROAD
 OCEAN SPRINGS MS
 (mailing address)

WELL LOCATION:
 sec. 8 T. 7 N. R. 7 E.
 3 miles NE of Ocean Springs
 (distance) (direction) (nearest town)

WELL PURPOSE: HOME
 (home, irrigation, municipal, industrial)

- WELL COMPLETION DATA:
- (1) diameter (inches) 2"
 - (2) total depth (feet) 233'
 - (3) static water level (feet) 20' below top of ground.
 - (4) casing PVC, 223' (material) (depth)
 - 2" (size) If telescope see back.
 - (5) screen 10' 223' (length) (depth to top)
 - 2" PVC (size) (material)
 - (6) pump L.P. 13 (HP) (yield gpm)
 - Electric (type power)
 - (7) electric log no (yes or no)
 - (organization running log)
 - (8) how well bottom plugged backwater valve

description of formations encountered	from	to
top soil	0	2
Brown Clay	2	14
White Coastal Sand	14	45
Blue Clay	45	70
White Coastal Sand	70	113
Blue Clay	113	175
Gray Coastal Sand	175	233
Blue Clay	233	238
		142

223
 10
 well 233


RECEIVED
 MAY 12 1986

Department of Natural Resources
 Bureau of Land & Water Resources

DRILLERS REMARKS: 5' - 2" PVC tail pipe

If well telescopes please sketch and show depths.

GROUND LEVEL

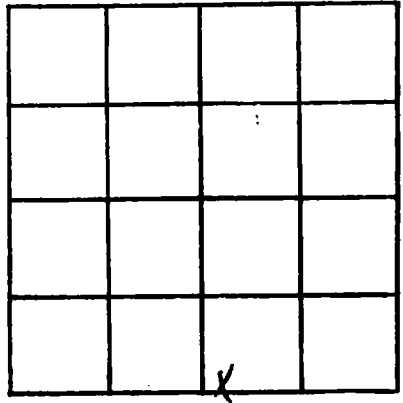

SECTION 8

Please indicate well location X.

ADDITIONAL INFORMATION

If more than one screen, show locations of each on sketch.