

MISSISSIPPI DEPARTMENT OF NATURAL RESOURCES

Bureau of Land and Water Resources

Southport Mall

P.O. Box 10631

Jackson, Mississippi 39209

WATER WELL DRILLERS LOG

JACKSON
Φ 2850

3-21-86

COAST WATER WELL SVC

JACKSON

date well completed

firm name

county well located

LANDOWNER: MIKE GOFF

3012 West Park Drive

Gautier, Miss. 39553  
(mailing address)

description of formations encountered

from

to

TOP SOIL

0

1

BROWN CLAY

1

13

WHITE COARSE SAND

13

27

BLUE CLAY

27

58

GRAY MED SAND

58

124

BLUE CLAY

124

160

MED GRAY SAND

160

250

WHITE COARSE SAND

250

280

BLUE CLAY

280

285

hole

WELL LOCATION:

sec. 26 T. 7 N. R. 7 W.  
IN miles (distance) of GAUTIER (direction) (nearest town)

WELL PURPOSE: HOME  
(home, irrigation, municipal, industrial)

WELL COMPLETION DATA:

(1) diameter (Inches) 2"  
(2) total depth (feet) 285'  
(3) static water level (feet) 12 (below/above top of ground)

(4) casing PVC, 270' (material), (depth)  
2" (size) If telescope see back.

(5) screen 10' (length), 270' (depth to top)  
2" PVC (size), (material)

(6) pump 1hp. (HP), 14 (yield gpm)  
Elec. (type power)

(7) electric log NO (yes or no)

(organization running log)

(8) how well bottom plugged BACKWASH VALVE

DRILLERS REMARKS:

5' - 2" PVC TAUPICE


RECEIVED

MAY 12 1986

Department of Natural Resources  
Bureau of Land & Water Resources

If well telescopes please sketch and show depths.

GROUND LEVEL

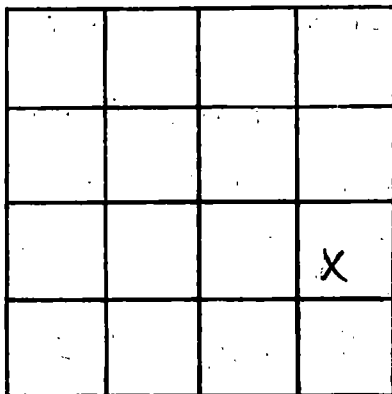

SECTION \_\_\_\_\_

Please indicate well location X.

ADDITIONAL INFORMATION

If more than one screen, show locations of each on sketch.