

MISSISSIPPI DEPARTMENT OF NATURAL RESOURCES

Bureau of Land and Water Resources

Southport Mall

P.O. Box 10631

Jackson, Mississippi 39209

WATER WELL DRILLERS LOG

Jackson  
 2052  
 ✓

4-2-86

19 Coast Water Well Svc

Jackson

date well completed

firm name

county well located

LANDOWNER: Alsay, Inc.

310 N. Kenmore Ave

Pensacola Fl 32503

(mailing address)

description of formations encountered

from

to

Blue Clay

0

75

White Coarse Sand

75

81

Blue Clay

81

100

White Coarse Sand

100

120

Water

WELL LOCATION:

sec. 19 T. 7 N. R. 7 E.

2 miles (distance) NE (direction) of Ocean Springs (nearest town)

WELL PURPOSE: Industrial  
 (home, irrigation, municipal, industrial)

WELL COMPLETION DATA:

(1) diameter (inches) 4"

(2) total depth (feet) 120'

(3) static water level (feet) 23 below top of ground.

(4) casing PVC (material), 100' (depth)

4" (size) if telescope see back.

(5) screen 30' (length), 100' (depth to top)

4" (size), PVC (material)

(6) pump (HP) (yield gpm)

(type power)

(7) electric log no (yes or no)

(organization running log)

(8) how well bottom plugged Backwash valve

100  
20  
120


RECORDED  
 MAY 12 1986

DRILLERS REMARKS:

Department of Natural Resources  
 Bureau of Land & Water Resources

If well telescopes please sketch and show depths.

GROUND LEVEL

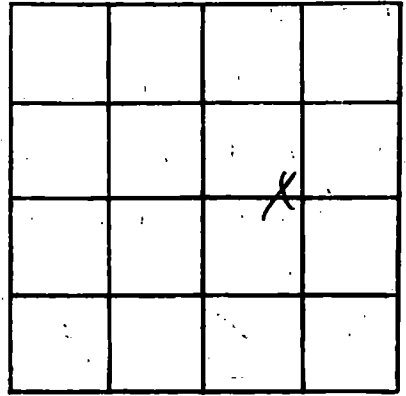

SECTION 19

Please indicate well location X.

ADDITIONAL INFORMATION

If more than one screen, show locations of each on sketch.