

MISSISSIPPI DEPARTMENT OF NATURAL RESOURCES

Bureau of Land and Water Resources

Southport Mall

P.O. Box 10631

Jackson, Mississippi 39209

WATER WELL DRILLERS LOG

Jackson
 # 2255

4-4-86 date well completed
 So Para Drilling Co. firm name
 Jackson county well located

LANDOWNER: Viola Roberts

Lountian Beau 955

Cautler Ms
 (mailing address)

WELL LOCATION:

sec. 19 T 8 N R 7 E
 4 miles South of Lountian Beau
 (distance) (direction) (nearest town)

WELL PURPOSE: Camp
 (home, irrigation, municipal, industrial)

WELL COMPLETION DATA:

- (1) diameter (inches) 2"
- (2) total depth (feet) 400'
- (3) static water level (feet) 27' below top of ground.
- (4) casing plastic, 390' (material) (depth)
- 0 (size) If telescope see back.
- (5) screen 10' 400' (length) (depth to top)
- 006, plastic (size) (material)
- (6) pump 1 (HP) 12 (yield gpm)
- electric (type power)
- (7) electric log (yes or no)
- (organization running log)
- (8) how well bottom plugged BW


description of formations encountered	from	to
Top Soil	0	10
Clay	10	50
good Sand	50	100
Clay	100	140
good Sand	140	160
Clay	160	380
good Sand	380	400

DRILLERS REMARKS:

RECEIVED
 MAY 14 1986
 Department of Natural Resources
 Bureau of Land & Water Resources

If well telescopes please
sketch and show depths.

GROUND LEVEL

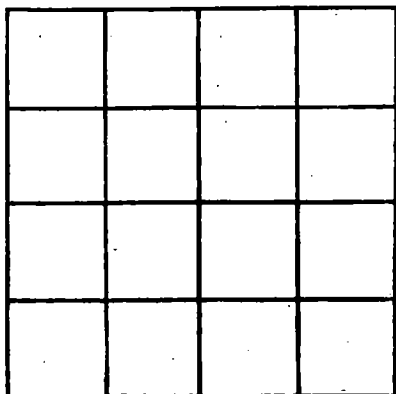

SECTION _____

Please indicate well location X.

ADDITIONAL INFORMATION

If more than one screen,
show locations of each on sketch.