

MISSISSIPPI DEPARTMENT OF NATURAL RESOURCES

Bureau of Land and Water Resources

Southport Mall

P.O. Box 10631

Jackson, Mississippi 39209

WATER WELL DRILLERS LOG

JACKSON
 2956
 ↓

4-5-86
 date well completed

Coast Water Well
 firm name

Jackson
 county well located

LANDOWNER: Jan O'Connell
5911 Mary Mahoney
Ocean Springs ms
 (mailing address)

WELL LOCATION:
 sec 5 T 8 R 7
4 miles (distance) SE of Ocean Springs (nearest town)

WELL PURPOSE: home
 (home, irrigation, municipal, industrial)

WELL COMPLETION DATA:
 (1) diameter (inches) 2"
 (2) total depth (feet) 373'
 (3) static water level (feet) 20 below top of ground.
 (4) casing PVC, 358' (material), (depth)
2" (size) if telescope see back.
 (5) screen 10', 358' (length), (depth to top)
2" (size), PVC (material)
 (6) pump _____ (HP) _____ (yield gpm)
 _____ (type power)
 (7) electric log no (yes or no)
 _____ (organization running log)
 (8) how well bottom plugged Backwash valve

Description of formations encountered	from	to
top soil	0	1
white coarse sand	1	9
Blue Clay	9	45
White Coarse Sand + Gravel	45	66
Blue Clay	66	135
Blue Clay + Clom shell	135	240
Blue Clay	240	345
Gray Coarse sand	345	368
Blue Clay	368	373


RECEIVED
 MAY 12 1986

DRILLERS REMARKS:
5' 2" PVC tail pipe

Department of Natural Resources
 Bureau of Land & Water Resources

If well telescopes please sketch and show depths.

GROUND LEVEL

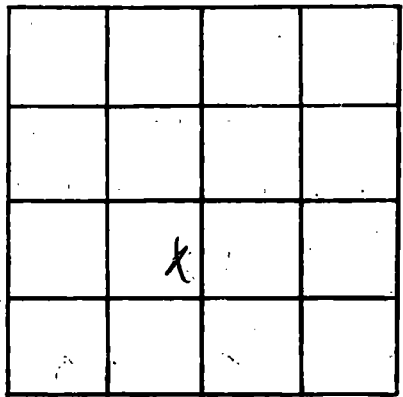

SECTION 5

Please indicate well location X.

ADDITIONAL INFORMATION

Lined area for additional information.

If more than one screen, show locations of each on sketch.