

MISSISSIPPI DEPARTMENT OF NATURAL RESOURCES

Bureau of Land and Water Resources

Southport Mall

P.O. Box 10631

Jackson, Mississippi 39209

WATER WELL DRILLERS LOG

JACKSON  
 ✓ \$2257

4-7-86  
 date well completed

Croot water well  
 firm name

JACKSON  
 county well located

LANDOWNER:	description of formations encountered	from	to
Hickory Hill Martin Bluff Rd. Gautier, Ms 39553 (mailing address)	Top soil	0	1
	Brown Clay	1	28
	White Coarse sand	28	75
WELL LOCATION: sec 12 T 7 N R 7 E 4 miles (distance) N of GAUTIER (nearest town)			
WELL PURPOSE: Irrigation (home, irrigation, municipal, industrial)			
WELL COMPLETION DATA:			
(1) diameter (inches) 4"			
(2) total depth (feet) 75'			
(3) static water level (feet) 17' below top of ground			
(4) casing PVC, 55' (material), (depth) 4" (size) if telescope see back.	SS 20 75		
(5) screen 20' (length), 55' (depth to top) 4" (size), PVC (material)			
(6) pump 2 (HP), 35 (yield gpm) Elet (type power)			
(7) electric log no (yes or no) (organization running log)			
(8) how well bottom plugged backwash valve			


RECEIVED  
 MAY 12 1986

Department of Natural Resources  
 Bureau of Land & Water Resources

DRILLERS REMARKS:

If well telescopes please sketch and show depths.

GROUND LEVEL

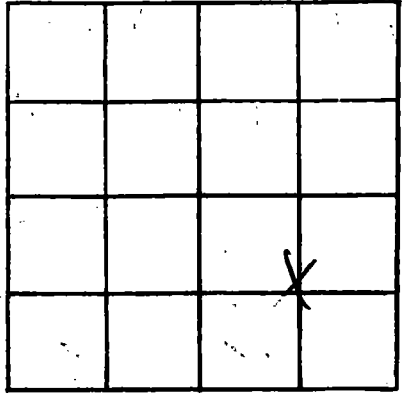

SECTION 12

Please indicate well location X.

ADDITIONAL INFORMATION

If more than one screen,  
show locations of each on sketch.