

MISSISSIPPI DEPARTMENT OF NATURAL RESOURCES

Bureau of Land and Water Resources

Southport Mall

P.O. Box 10631

Jackson, Mississippi 39209

WATER WELL DRILLERS LOG

JACKSON
 0728

4-19-86

Coast Water Well

Jackson

date well completed

firm name

county well located

LANDOWNER: Charles Shuttis

description of formations encountered

from

to

old Spanish Trail

Top Soil

0

1

Gautier, Ms, 39553

Coarse sand

1

3

(mailing address)

WELL LOCATION:

sec 38 T 7 N R 7 E

Blue Clay

3

44

3 miles West of GAUTIER

White Coarse sand

44

70

(distance) (direction) (nearest town)

WELL PURPOSE: home
 (home, irrigation, municipal, industrial)

Blue Clay

70

93

WELL COMPLETION DATA:

White Coarse sand

93

105

(1) diameter (inches) 2"

Blue Clay

105

120

(2) total depth (feet) 515"

Fine Gray sand

120

140

(3) static water level (feet) 53 below above top of ground.

Med Gray sand

140

163

(4) casing PVC, 500' well 510'
 (material) (depth)

Blue Clay

163

186

2" if telescope see back.
 (size)

Blue fine sand

186

193

(5) screen 10' 500'
 (length) (depth to top)

Blue Clay

193

240

2" PVC
 (size) (material)

Blue Clay w/ streak of sand

240

252

(6) pump _____
 (HP) (yield gpm)

Blue Clay

252

477

_____ (type power)

Fine sand

477

493

(7) electric log no
 (yes or no)

Coarse sand

493

510

_____ (organization running log)

Blue Clay

510

515

(8) how well bottom plugged backwash valve

Blue Clay

515

Water

DRILLERS REMARKS:


5' 2" PVC tail pipe

well 510' 2 1986

Department of Natural Resources
 Bureau of Land & Water

If well telescopes please sketch and show depths.

GROUND LEVEL

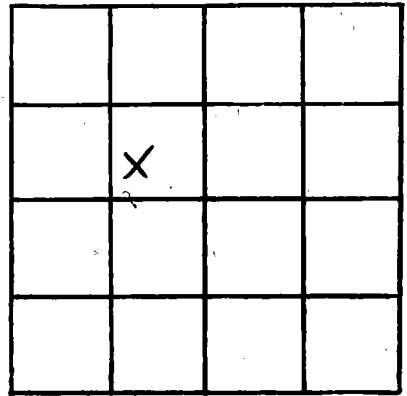

SECTION _____

Please indicate well location X.

ADDITIONAL INFORMATION

If more than one screen, show locations of each on sketch.