

MISSISSIPPI DEPARTMENT OF NATURAL RESOURCES

Bureau of Land and Water Resources

Southport Mall

P.O. Box 10631

Jackson, Mississippi 39209

WATER WELL DRILLERS LOG

JACKSON
 2260
 ✓

4-1-86 19 Coast Waterwell Jackson
 date well completed firm name county well located

LANDOWNER: Osadolo Hyatt
 4900 Old Spanish Trail
 Gautier, Ms.
 (mailing address) 37533


WELL LOCATION:
 sec. 31 T. 7 S. R. 7 E.
2 miles EAST of Ocean Springs
 (distance) (direction) (nearest town)

WELL PURPOSE: home
 (home, irrigation, municipal, industrial)

WELL COMPLETION DATA:
 (1) diameter (inches) 4" x 2"
 (2) total depth (feet) 538
 (3) static water level (feet) 62 ^{below} _{above} top of ground. 200' - 4"
 (4) casing PVC 313' - 2"
 (material) 513' well
4" x 2" If telescope see back 333
 (size)
 (5) screen 20' 513'
 (length) (depth to top)
2" PVC
 (size) (material)
 (6) pump 1 hp. 20
 (HP) (yield gpm)
Electric
 (type power)
 (7) electric log no
 (yes or no)
 (organization running log)
 (8) how well bottom plugged Backwash valve


Description of formations encountered	from	to
Top Soil	0	3
Red coarse sand	3	27
Blue Clay	27	49
Blue Clay + Oyster Shell	49	60
White coarse sand	60	81
Blue Clay	81	120
White coarse sand	120	155
Blue Clay	155	270
Blue Clay + streak of sand	270	292
Blue Clay + Oyster Shell	292	320
Blue fine sand	320	342
Blue clay	342	350
Blue Clay + Oyster Shell	350	396
Blue Clay	396	420
Gray coarse sand	420	436
Blue Clay	436	485
Gray Fine Sand	485	495
Gray coarse sand	495	533
Gray coarse sand	533	538
Gravel + wood		1 ft. r.

DRILLERS REMARKS:
5' - 2" PVC tailpipe

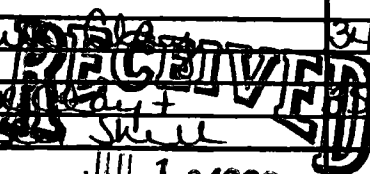

If well telescopes please sketch and show depths.

GROUND LEVEL

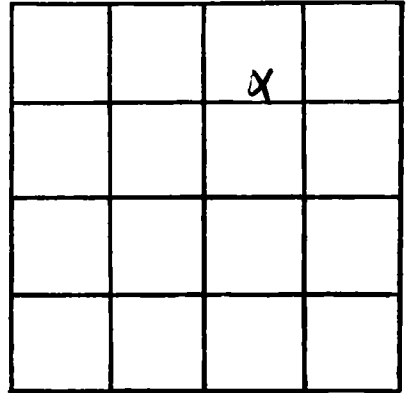

SECTION 31

Please indicate well location X.

ADDITIONAL INFORMATION

If more than one screen,
show locations of each on sketch.